
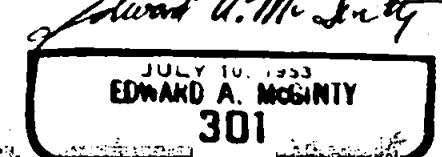


SURVEY IN S.W. 1/4 SEC. 2, T.38 S., R.2 W., W.M.
FOR
DON ROOT
64-31

BY EDWARD MCGINTY
MEDFORD OREGON
AUGUST 1964

SCALE 1" = 100'
◎ = 1 1/2" I. PIPE
○ = 5/8" I. PIN

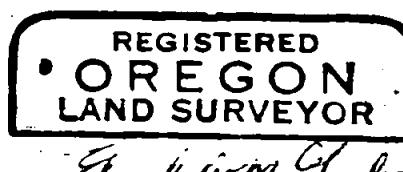

2727

Survey No.

2727

Survey Narrative to comply with O.R.S. 209-250:

Survey for: Donald Root
341 Saginaw, Medford

Survey by: Edward A. McGinty, L.S.
Aug. 1964

BASIS OF BEARING: Solar observation

PRECEDENCE OF SURVEY:

1. At the NE. corner of DLC No. 46 found a $1\frac{1}{2}$ in. iron pipe, approx. 24 ins. deep with 5/8 in. iron pin over the top, approx. 2 ins. below the surface.
2. SES cor. of DLC No. 46 found a $1\frac{1}{2}$ in. iron pipe 4 ins. deep.
3. WNW cor. of DLC No. 47 found a $1\frac{1}{2}$ in. iron pipe flush with the surface.
4. Found a 5/8 in. iron pin, 4 ins. deep.
5. Set a 5/8 in. iron pin, 24 ins. long, 4 ins. deep, from which a 5/8 in. iron pin bent over, bears approx. 0.32 ft. South and 0.83 ft. west.
6. Set a 5/8 in. iron pin, 24 ins. long, flush with the surface, from which a 5/8 in. iron pin bears approx. 0.22 ft. North and 1.52 ft. East

All other monuments set being 5/8 inch X 24 in. iron pins, set flush with the surface.

