

SURVEY NARRATIVE TO COMPLY WITH O.R.S. 209.250, REVISED BY CHAPTER 555, O. L. 1963


FOR - ELK LUMBER COMPANY
P. O. BOX 606, MEDFORD, OREGON

PURPOSE - To remonument and perpetuate the quarter section corner common to section 1, Township 32 South, Range 1 East and Section 6, Township 32 South, Range 2 East, Willamette Meridian.

PROCEDURE -

Found the remains of the original Southwest BT which is now a 46 inch Douglas fir stump. A portion of the upper face was exposed in the undercut and we sawed in 13 inches at the base of the stump and exposed the "BT" scribing intact. Found no identifiable remains of the original Northeast BT.


At the record bearing and distance from the above described original Southwest BT, set a 1 inch by 36 inch galvanized steel pipe driven 18 inches in the ground and capped with a 1-1/2 inch to 1 inch galvanized bell reducer filled with pot metal and stamped as shown below in 1/8 inch letters and numerals:

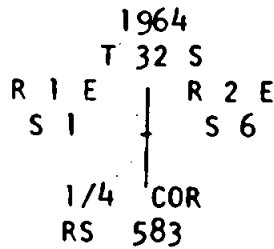

From the above described corner monument a 10 inch White fir bears North 60° West 41.2 feet and a 31 inch Madrone bears North 85°30' East 28.5 feet. Both trees are double blazed and scribed "RS 583" in the upper blaze and "BT" in the lower.

Distances were measured to face of blaze and compass variation was set at 20°00' East.

Field work by B. Brandt and R. Vincent, December 16, 1964.

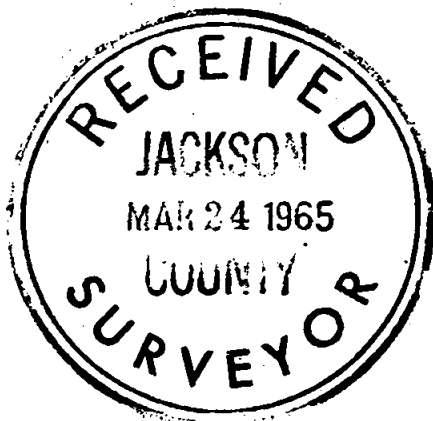

Robert M. Vincent

