

SURVEY NARRATIVE TO COMPLY WITH O.R.S. 209.250, REVISED BY CHAPTER 555, O. L. 1963

FOR - ELK LUMBER COMPANY
P. O. BOX 606, MEDFORD, OREGON

PURPOSE - To remonument and perpetuate the quarter section corner common to sections 6 and 7, Township 32 South, Range 2 East, Willamette Meridian.

PROCEDURE -

Found both original BT's in poor condition. The original Northeast BT is now a dead and down 18 inch White fir with scribing exposed and legible. The original Southwest BT is now a 24 inch Douglas fir snag with both faces closed.

At the corner point, as determined from record bearings and distances from the original BT's, set a 1 inch by 36 inch galvanized steel pipe driven 10 inches in the ground and capped with a 1-1/2 inch to 1 inch galvanized bell reducer filled with pot metal and stamped as shown below in 1/8" letters and numerals.

1964

T 32 S R 2 E

S 6
S 7


1/4 COR
RS 583

NEW BEARING TREES:

From the above described pipe monument a 21 inch Sugar pine bears North 13° West 19.5 feet and a 25 inch Douglas fir bears South 18° East 21.95 feet. Both new BT's are double blazed and scribed "RS 583" in the upper blaze and "BT" in the lower.

Distances were measured to face of blaze and compass variation was set at 20° 00' East.

Field work by R. Vincent and B. Brandt, December 16, 1964.

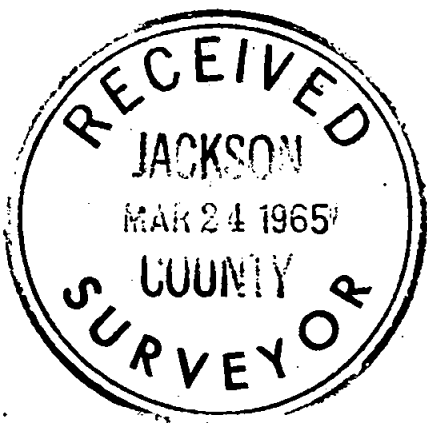

Robert M Vincent

