

2744

31 1" Pipe  
⑥ --- E 138.36  
6  
T. 37 S. R. 2 W

REGISTERED  
OREGON  
LAND SURVEYOR  
*L. N. Dow*  
MAY 6, 1949  
L. N. DOW  
251

Survey for Mr. Curtis C. Johnson  
R 1 Box 269C Old Stage Road  
Central Point, Oregon.

Date February 13, 1965  
Located in NE quarter S 6, T 37S, R 2 W  
Jackson County, Oregon.

Bearings from survey NO. 807



P. I. found

3/4" bolt f 12" down  
11.60

S 452.09

S 66°57'E Rec S 67°01'E  
161.00

S 68°03'E  
8.20

S 68°03'E  
STAGE ROAD

old 5/8" bolt 4" down  
3.47

bar at angle f.



SCALE 1" = 100'

5/8" x 24" bars set at corners indicated o

124.00

S 18°56'W 193.97  
Rec S 18°52'W

108.53

S 8°43'W 201.01

148.00

S 8°43'W 203.75  
Rec S 8°39'W

N 67°16'W

Rec N 67°20'W

144.35

148.00

Nail in License plate in  
corner fence post

2744

2744

Written narrative to accompany plat for Survey NO. \_\_\_\_\_



Survey for Mr. Curtis C. Johnson, R1Box 269C Old Stage Road  
Central Point, Oregon.

Located in NE quarter of Section 6 T 37S, R 2 W Jackson County, Oregon.

Date February 13, 1965 Bearings from Survey NO. 807.

Survey records for the area was looked over, deed descriptions obtained, and found that the original deeds for this area were made prior to the additional County Acquisition for right of way.

A tie was run from the 1/4Section corner on deed bearings to locate any original points, after much effort a 3/4" bolt at the Northeast corner and a 5/8" bar at the southeast corner of the parent tract was found. Re tying to the original points and using these as control for the area being surveyed, and using county road points as shown on the plat for right of way control 5/8" bars 24" long was placed at points as shown on the plat.

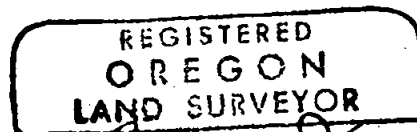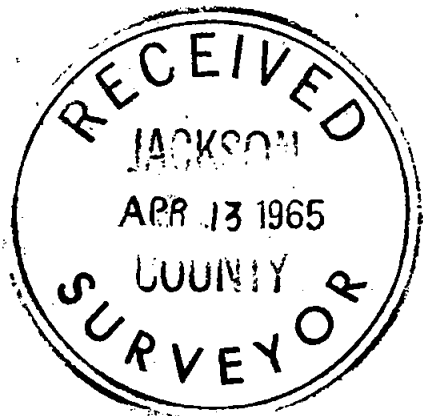

*L. N. Dow*

