

2745

35 | 36
2 | 1

West
2069.93 (Record)

1/4
Cor.

2 | 1
11 | 12

P.
South
351.87 (Record)

351.87 (Record)

Record
S. 40° 34' E. 458.54

Left Fork Fools Creek Road
S. 40° 34' E.

N. 61° E.
Set 190

Set 190

229.27

1 A.

Set 190

229.27

S. 61° W.

Set 190

229.27


60



N. 59° 47' E.
1625.19 (Computed)

METES AND BOUNDS SURVEY
IN S.E. 1/4 SEC. 2 T. 37S., R. 4 W.
W. M. JACKSON COUNTY, OREGON
FOR L. J. COWIE
MARCH 1, 1965
Scale 1 inch = 200 feet

REGISTERED
OREGON
LAND SURVEYOR
Marvin C. Ramsey
MAY 10, 1957
MARVIN C. RAMSEY
405

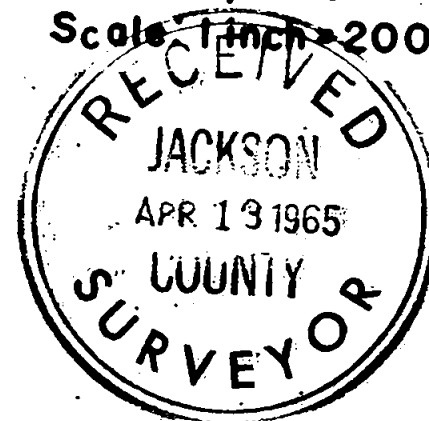

2745

METES AND BOUNDS SURVEY IN THE SOUTHEAST $\frac{1}{4}$ OF SECTION 2
 T. 37 S., R. 4 W. W. M., JACKSON COUNTY, OREGON FOR
 L. J. COWIE; MARCH 1, 1965

Found a $\frac{3}{4}$ inch iron pipe from which the $\frac{1}{4}$ section corner of sections land 2 bears East 2069.93; thence South 351.87 fail to find an iron pipe; thence S. $40^{\circ} 25'$ E. 84 feet to a $\frac{1}{2}$ inch iron pipe 4.5 feet inside of the right of way line of Left Fork of Foots Creek Road. See survey number 906. Thence I run S. $40^{\circ} 34'$ E. along the right of way line of the Left Fork of Foots Creek Road 458.54 feet and set a $\frac{3}{4}$ inch iron pipe at the point of beginning; thence N. 61° E. 190 feet and set a $\frac{3}{4}$ inch iron pipe; thence S. $40^{\circ} 34'$ E. 229.27 feet and set a $\frac{3}{4}$ inch iron pipe; from this point the $\frac{1}{4}$ section corner bears N. $59^{\circ} 47'$ E. 1625.19 feet; thence S. 61° W. 190 feet and set a $\frac{3}{4}$ inch iron pipe; thence N. $40^{\circ} 34'$ W. 229 feet along the right of way line to the point of beginning. Containing 1 acre.

