



2747

S. 27 S. 26
S. 34 S. 35

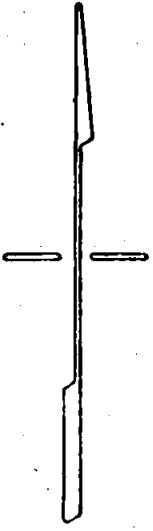

1343.58'
1343.58'
5374.32' E
N 0°24'30" E
1/4 CORNER
1943.58'
2687.16'

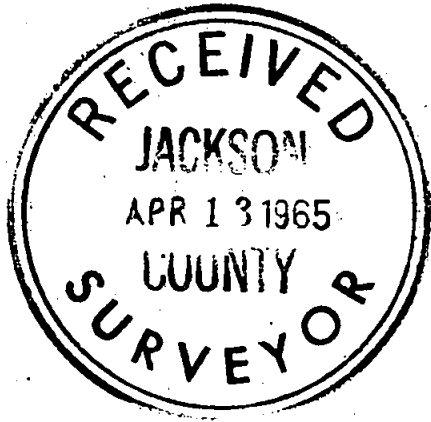

REGISTERED
OREGON
LAND SURVEYOR

Edward A. McGinty

JULY 10 1953
EDWARD A. MCGINTY
301

SURVEY SEC. LINE 34 & 35 T.37S., R.3W.W.M.
JOHN BLACK
64 - 11

BY EDWARD MCGINTY
MEDFORD, OREGON
APRIL 30 1964
REV. MAR 1965

SCALE 1" = 500'
o = 5/8" PIN
© = C. SUR. REEST.

S. 34 S. 35
S. 3 S. 2

2747

Survey No. 2747


Survey Narrative to comply with O.R.S. 209-250.

Survey for: John Black

Survey by: Edward A. McGinty, L.S.
March 31, 1965



Edward A. McGinty

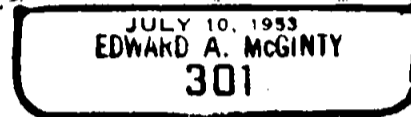

BASIS OF BEARING: Survey No. 2493.

PRECEDENCE OF SURVEY:

From traverse on survey no. 2493, set a 5/8 inch iron pin, 24 ins. long, 4 ins. above the ground at the one quarter corner between Sec. 34 and 35, from which

Double blaze, douglas fir, 6 ins. diam., bears N. 85° E., 69.6 ft. to face of high blaze

A 3/4 in. iron pipe, bears N. 69° 38' W., 13.82 ft., see narrative on survey no. 2493.

North 1/16 cor. between Sec. 34 and 35, set a 5/8 inch iron pin, 24 ins. long within 2 ins. of the surface, from which


double blazed douglas fir, 9 ins. diam., bears N. 71° 30' W., 12.65 ft. to face of low blaze

double blazed cedar, 10 ins. diam., bears S. 27° E., 17.23 feet to face of lower blaze.

South 1/16 cor. between Sec. 34 & 35, set a 5/8 x 30 in. iron pin flush with the surface, from which

The center of a double blazed fir, 9 ins. diam., bears S. 68° 40' E., 31.1 ft. dist.

The center of a double blaze fir, 10 ins. diam., bears S. 6° 25' E., 25.4 ft. distance.

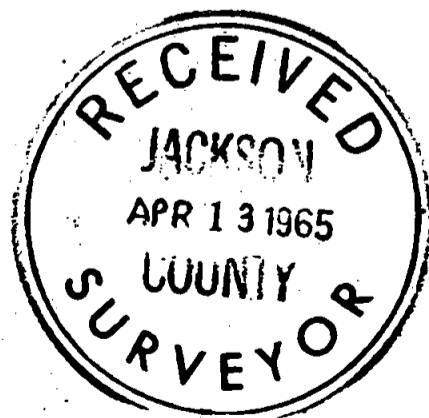

64-11