


Curve No. 4	Curve No. 3	Curve No. 2	Curve No. 1
$\Delta = 49^{\circ}12'$	$\Delta = 31^{\circ}36'$	$\Delta = 19^{\circ}08'$	$\Delta = 30^{\circ}45'$
$D = 46^{\circ}34'$	$D = 40^{\circ}$	$D = 10^{\circ}34'$	$D = 23^{\circ}39\frac{1}{2}'$
$R = 123.03$	$R = 143.24$	$R = 542.29$	$R = 242.35$
$T = 56.33$	$T = 40.53$	$T = 86.55$	$T = 66.64$
$L = 105.65$	$L = 79.00$	$L = 171.63$	$L = 130.07$

o Set $\frac{1}{2}$ " Iron pipe

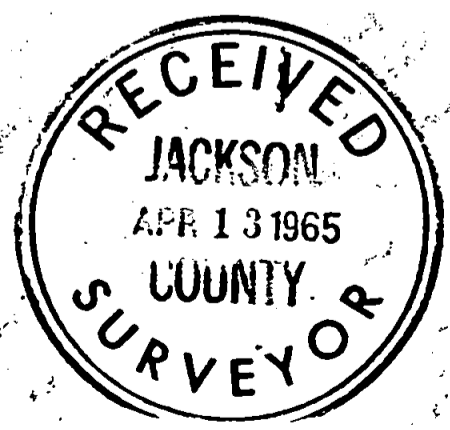

Map for revision of descriptions Jan. 1965
 LITTLE BUTTE CREEK PARK NO. 2 & NO. 1
 FAYDREX, INC.
 SEC. 36, T. 35 S., R. 1 W., W.M.
 Scale: 1" = 200'
 January, 1962

2754

See Recorded Survey # 2176

Tom R. Cleave

2754

January 12, 1965

Survey Number 2754

Survey Narrative to comply with paragraph No. 209 250, ORS
Survey for Troy Drexler, F.O.Box 1106, Medford, Oregon.

Purpose to record a correction in the bearing of the South
line of Section 36, Township 35 South, Range 1 West, of the
Willamette Meridian, Jackson County, Oregon and to show a
relation between the South line of Little Butte Creek Park
No. 2 with the North line of Little Butte Creek Park No. 1.

Procedure: In the survey narrative that was issued January
10, 1962, the ~~true~~ course, from the Southwest corner of the
above said Section 36 to the South quarter corner was given
to be North $89^{\circ}53'$ west. This remains the same but the sur-
vey continued North $89^{\circ}53'$ west to the center line of Little
Butte Creek. After that time, the Southeast corner of said
Section 36, was established and the true bearing of the line,
from the South quarter corner of said Section 36 to the South-
east corner of the Section, was found to be South $89^{\circ}55'$ west.
Due to this correction, a revision of descriptions of land
adjoining the Section line, has been made.

Tom R. Pearce

Tom R. Pearce, Registered Engineer
No. 838.

