

2772


REGISTERED
OREGON
LAND SURVEYOR

Mark E. Boyden
NOVEMBER 9 1951
MARK E. BOYDEN
281

RECEIVED
JACKSON
APR 29 1965
COUNTY &
SURVEYOR

Survey For:
SETH COY
Located in the NW 1/4,
Sec. 21, T.36S.R.3W, W.M.
By Mark E. Boyden,
April 21, 1965.

Section Corner
17 16
20 21
East
15427'

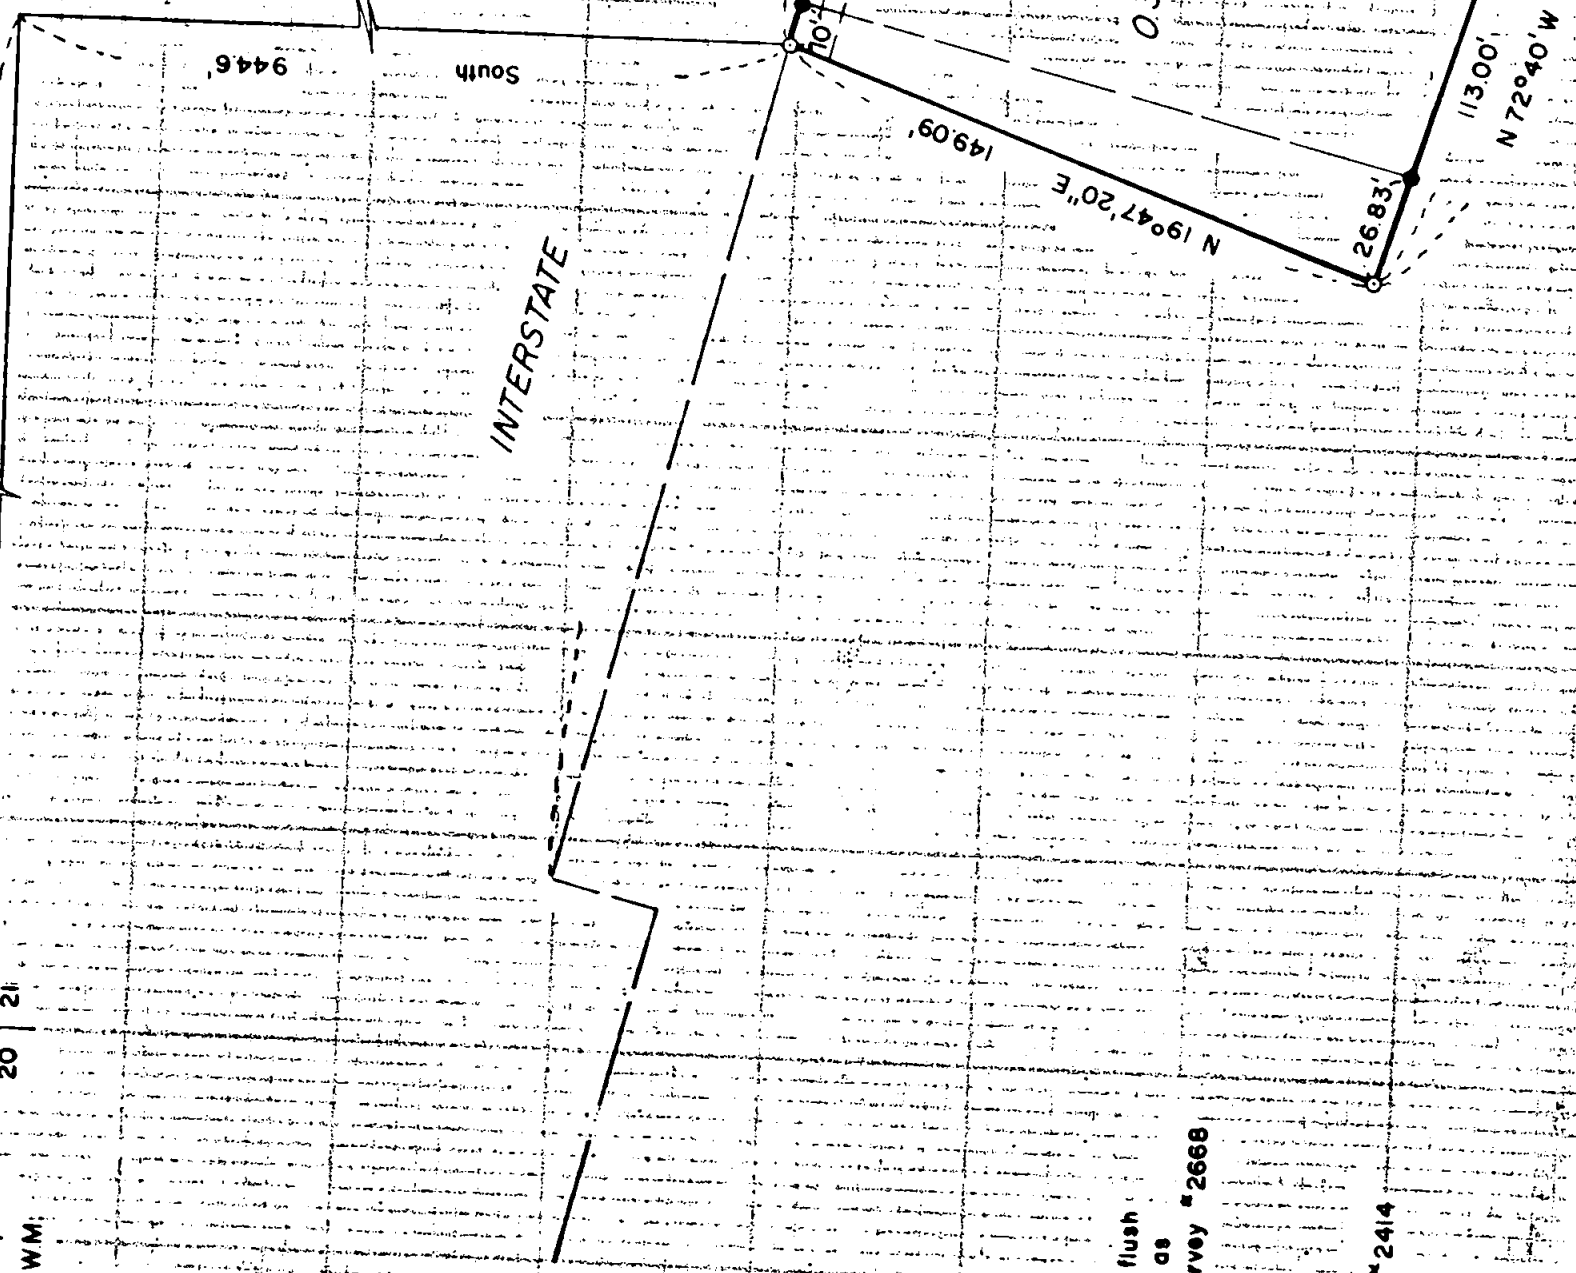

SCALE: 1" = 50'

- found 5/8" x 30" iron pin flush
- re-set 5/8" iron pin flush as found set on Recorded Survey # 2668

Basis of Bearings:
Recorded Survey # 2414

2772

2772

SURVEY NARRATIVE TO COMPLY WITH O.R.S. 209.250
REVISED BY CHAPTER 555, O.L. 1963

FOR: Seth Coy
Rt. 1, Box 51
Gold Hill, Oregon

PURPOSE: To remonument and re-describe a residence parcel
previously monumented and described on December 10, 1964
(see Recorded Survey No. 2668).

PROCEDURE:

Found the lot pins previously set on Recorded Survey No. 2668
in good condition.

Re-set the pins at new positions shown on the attached map,
and prepared a revised legal description thereof.

April 21, 1965

