

Survey No. 2780

SURVEY NARRATIVE TO COMPLY WITH O. R. S. 209.250, REVISED BY CHAPTER 555,
O. L. 1963.

FOR - ELK LUMBER COMPANY
P. O. BOX 606, MEDFORD, OREGON

PURPOSE -

To rehabilitate and perpetuate the South quarter corner of section 33, Township 31
South, Range 2 East, Willamette Meridian.

PROCEDURE -


Found the original stone monument in place. The stone conforms in size and markings
to the description in the official record. Also found sprout growth and the decayed remains
of the original northeast BT and the decayed roots and root collar of the original northwest
BT.

Left the original monument in place and along the east side thereof set a 1 inch by
36 inch galvanized steel pipe driven 30 inches in the ground and capped with a 1-1/2 inch
to 1 inch galvanized bell reducer filled with pot metal and stamped as shown below in
1/8 inch letters and numerals:

1965
T31S R2E WM
S 33
S 1/4 COR
RS 583

From this pipe monument a 7 inch Douglas fir bears North 86° West 2.75 feet and a
7 inch Douglas fir bears North 88° East 24.9 feet. Both trees are double blazed and
scribed "RS 583" in the upper blaze and "BT" in the lower. Distances were measured
to face of blaze and compass variation was set at 20° 00' East.

Field work completed April 15, 1965.

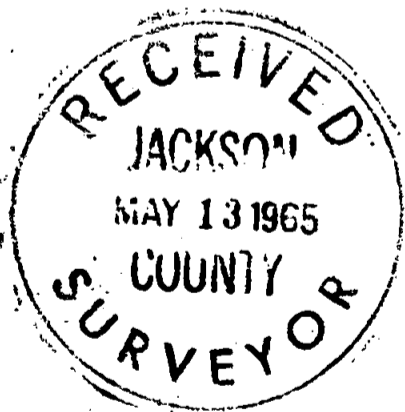

Robert M. Vincent

