

2811

RESTORED CORNER FOR STATE OF OREGON-DEPARTMENT OF FORESTRY

Section corner common to Sections 3, 4, 9 and 10, T33S,  
R1E, W.M., Jackson County, Oregon.

ORIGINAL

Black Oak post (now missing) from which a:

- 8" Black Oak bears N21E 47 lks.; now 12", faces covered.
- 32" Fir bears S31E 40 lks.; now 40", scribes BT showing in bark, top face covered.
- 5" Black Oak bears S63W 25 lks.; now 8" faces covered.
- 5" Black Oak bears N65W 30 lks.; now 10", faces covered.

RESTORED

Set 1½" x 36" galvanized iron pipe with 3" bronze cap marked  
"OREGON STATE BOARD OF FORESTRY T33S R1E S3 S4 S9 S10 1964  
RS 359", 30 inches in ground, and from which a:


- 10" Sugar Pine bears N6½E 16.3 ft.; scribed T33S R1E S3 BT RS359.
- 8" Sugar Pine bears N43W 18.2 ft.; scribed T33S R1E S4 BT.
- 10" Sugar Pine bears S76½W 38.0 ft.; scribed T33S R1E S9 BT.

Set 4 x 4 x 72" white painted Cedar post 1.0 ft. SE of corner pipe.  
Oregon State Forestry Department metal location poster on original  
32" Fir BT.

Dated January 21, 1965



Restored by

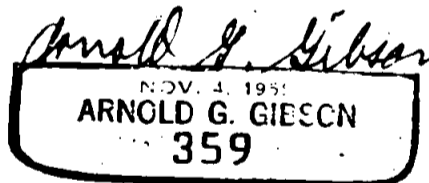

Present and witnessed by Richard Olsen  
Marvin Pounds

