

2813

RESTORED CORNER FOR STATE OF OREGON-DEPARTMENT OF FORESTRY

One quarter corner common to Sections 4 and 9, T33S,
R1E, W.M., Jackson County, Oregon.

ORIGINAL

White Oak Post (missing, in open glade) from which a:

15" Black Oak bears N14W 22 lks.; now 36", face covered,
(distance is 149 ft., 22 probably should have been 220).

5" White Oak bears S34E 83 lks.; now 20", scribes $\frac{1}{4}$ S visible.
Trail, course N & S, 95 links East; in place.

RESTORED

Set $1\frac{1}{2}$ " x 36" galvanized iron pipe with 3" bronze cap marked "OREGON
STATE BOARD OF FORESTRY $\frac{1}{4}$ S4 S9 1964 RS 359", and from which a:

12" Fir bears S44 $\frac{1}{2}$ E 58.6 ft.; scribed $\frac{1}{4}$ S9 BT RS 359.


Set 4x4x72" white painted Cedar post 1.0 ft. NW of corner pipe.
Oregon State Forestry Department metal location poster on 10" White
Oak N73E 88.0 ft.

Dated January 21, 1965

Restored by



Arnold G. Gibson

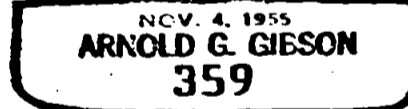

Present and witnessed by Marvin Pounds
Mike Miller

