

RESTORED CORNER FOR STATE OF OREGON-DEPARTMENT OF FORESTRY

One quarter corner common to Sections 33 and 4, T32 and 33S, R1E, W.M., Jackson County, Oregon.

ORIGINAL

Black Oak post (missing) from which a:

- 4" Black Oak bears N17E 15 lks.; now missing.
- 5" Fir bears S25E 12 lks.; now 14" by 15 ft. high stub, scribes $\frac{1}{4}$ S visible, BT face covered.

RESTORED

Set 1 $\frac{1}{2}$ " x 36" galvanized iron pipe with 3" bronze cap marked "OREGON STATE BOARD OF FORESTRY $\frac{1}{4}$ S33 S4 1964 RS 359", in mound of rock, and from which a:


- 11" Fir bears N34 $\frac{1}{2}$ E 99.5 ft.; scribed $\frac{1}{4}$ S33 BT RS 359.
- 12" Fir bears S37E 17.5 ft.; scribed $\frac{1}{4}$ S4 BT.

Set 4 x 4 x 72" white painted Cedar post 1.0 ft. SE of corner pipe.
Oregon State Forestry Department metal location poster on 11" Fir S77E 12.4 ft.

Dated January 21, 1965



Restored by

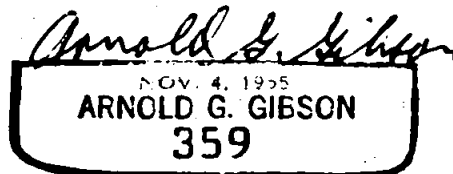

Present and witnessed by William Pope
Marvin Pounds

