

Secs. 26 & 27
1/4 Sec. Cor.
1" pipe

N88°17'W 2294.07'
(RS 273)
L.C. N28°40'E, 30.88'

Fd. 11/4" I. pin
279.54'

N88°48'45"W 331.7'

ROAD
N 24°55'E
279.54'

Fd. 18"x18" stone
with 'X', 12" deep
43.42'

N87°59'W 300.0'

N87°48'10"W 442.06'

SCHOOL DISTRICT 549
Deed Vol. 353, pgs. 59 & 60
(see Recorded Survey #273)

S87°59'E 952.37'

SCHOOL DIST. 549 (Deed Vol. 370, pgs. 305)

440.87'

S87°59'E

S 2°01'W 276.14'

4.05 AC

494.6'

S87°59'E

S 2°01'W 360.0'

S 91.02'

Fd. 5/8" I. pin
NW Cor. L1, B1

Lo 1

Bk 1

SUNSHINE VILLAGE
(RECORDED)


Fd. 5/8" I. pin
NE Cor. L1, B1

60.0'

APPLGATE

N24°53'50"E

Fd. 5/8" I. pin
SW Cor. L1, B1

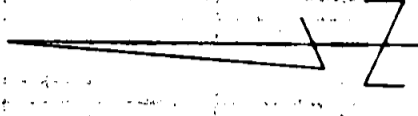

SCALE: 1"=100'

O Set 5/8" X 24" iron pin flush

Basis of Bearings: Recorded Survey No. 273

Survey for:

School District 549

Located in the SW 1/4 of Sec. 27


T 36SR3W, W.M.

By: Mark E. Boyden

July 27, 1965

REGISTERED
OREGON
LAND SURVEYOR

Mark E. Boyden
NOVEMBER 9 '81
MARK E. BOYDEN
281

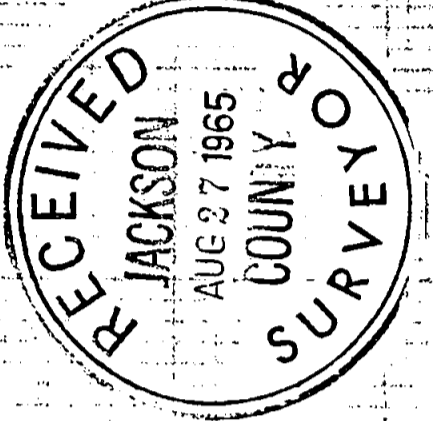

Survey No. 2854

SURVEY NARRATIVE TO COMPLY WITH O.R.S. 209.250
REVISED BY CHAPTER 555, O.L. 1963

FOR: School District 549
500 Monroe Street
Medford, Oregon

PURPOSE: To monument and describe a parcel of land lying adjacent to Lot 1, Block 1 of SUNSHINE VILLAGE (recorded) and adjacent to school property described in Volume 370, Page 305 of the Deed Records of Jackson County, Oregon, proposed to be purchased from Lewis Buckley.

PROCEDURE:

From control monuments found set on Recorded Survey No. 273 and SUNSHINE VILLAGE SUBDIVISION, established the desired tract corners. Then monumented and described same as shown on the map to accompany this report.

August 16, 1965

