

SURVEY NARRATIVE TO COMPLY WITH O. R. S. 209-250
AMENDED BY CHAPTER 555, O. L. 1963

FOR - ELK LUMBER COMPANY
P. O. BOX 606, MEDFORD, OREGON

PURPOSE - To rehabilitate and perpetuate the one quarter section corner common to Sections 12 and 13, Township 32 South, Range 1 East, Willamette Meridian.

PROCEDURE - Found the original corner monument which is a stone of approximately record dimensions with the "1/4" marking plainly legible. Also found a three quarter inch by 36 inch steel pipe driven 20 inches in the ground and capped with a one and one half to three quarter inch galvanized bell reducer filled with potmetal and stamped as shown below:


4-12-1950
T. 32S R1E
12
13
1/4 COR

This pipe was set by R. Vincent and John Fleeger. The remains of the Southeast BT are still visible but badly deteriorated, no scribe marks being recovered. No trace of the original Northwest BT.

I added "RS 583 1965" to the stamping on the above described corner monument and marked new BTs as follow:

~~For~~ ^{From} the corner monument a 22 inch Douglas fir bears North $58^{\circ} 30'$ East 6.42 feet to face of bottom blaze and a 35 inch Sugar Pine bears South 07° East 17.4 feet to face of upper blaze. Both trees are double blazed and scribed "R. S. 583" in the upper blaze and "BT" in the lower.

Compass variation set at $20^{\circ} 30'$ East.
September 1, 1965.

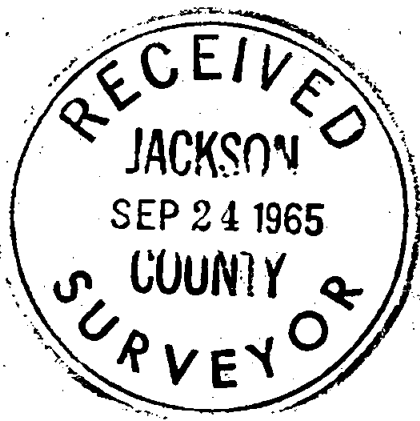

Robert M. Vincent

