

SURVEY NO. **2880**

SURVEY NARRATIVE TO COMPLY WITH ORS 209.250,
AMENDED BY CHAPTER 555, O. L., 1963.

FOR: ELK LUMBER COMPANY
P. O. BOX 606, MEDFORD, OREGON

PURPOSE: To rehabilitate and perpetuate the section corner common to Sections 21, 22, 28 and 27, Township 32 South, Range 2 East, Willamette Meridian.

PROCEDURE -

At the corner point found an old wooden stake which I know to have been set from the original Northeast and Northwest BT's when those trees were still in place. These two trees are both down, with definite stump holes to mark their positions. The original Northwest BT has legible scribing in the upper face. Also found scattered remains of the Southeast and Southwest BT's but no definite stump holes to mark their position when standing.

At the corner point, as marked by the old stake, set a one inch by 36 inch galvanized steel pipe driven 26 inches in the ground and capped with a one and one half inch to one inch galvanized bell reducer filled with pot metal and stamped as shown below in one eighth inch letters and numerals:



1965
T32S R2E WM
21 / 22
28 / 27
SEC. COR
R S 583

From the above described corner monument a 16 inch Douglas fir bears North 46° East 42.25 feet; a 27 inch white fir bears South 80° East 21.35 feet; a 12 inch white fir bears South 26° West 47.2 feet, and a 25 inch Hemlock bears North 42° West 32.5 feet. All these trees were double blazed and scribed "RS 583" in the upper blaze and "BT" in the lower.

Distances were measured to face of blaze.

Bearings were read with a pocket compass with variation set at $20^{\circ} 00'$ East.

Field work on September 3, 1965.

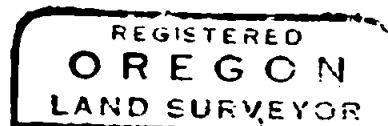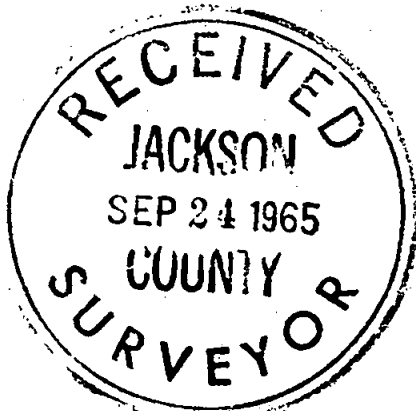

Robert M Vincent

