

2894

SECTION CORNER  
FOUND7 8  
16 17

ROAD

AVE. "H"

S 89° 48' 00" E

317.09'

334.85'

ST.

N 0° 12' 00" E

549.50'

S 0° 12' 00" W

549.50'

50' 50'

432.525'

S 0° 17' 40" E

AGATE

S 89° 48' 00" E

170.00'

117.00'

170.00'

117.00'

317.09'

168.825'

N 89° 48' 00" W

AVE. "G"

N 89° 48' 00" W

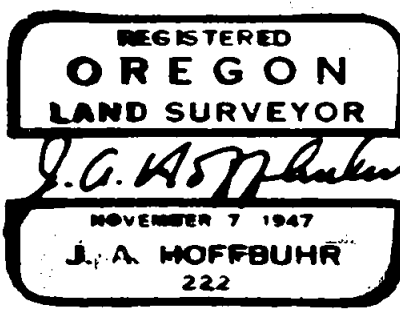
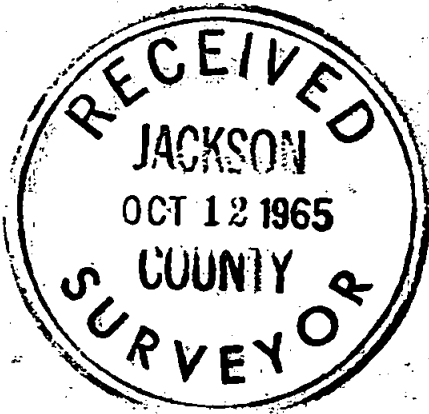
707.77'

0.07'

1.03'

1428.24'

N 0° 15' 00" W

SECTION CORNER  
FD. LEAD PLUG IN  
CONC. ROADWAY18 17  
19 20

## MAP OF SURVEY

LOCATED IN

S.E. 1/4 OF SEC. 18, T. 36 S., R. 1 W., W.M.  
JACKSON COUNTY OREGON

FOR

WHITE CITY CORP.

J.A. HOFFBUHR L.S. MEDFORD, OREGON

SCALE: 1" = 200' AUGUST 2, 1965

BEARINGS PER RECORDED SURVEY NO. 1004

O = SET 3/8" X 24" I.R.E.M.P. PIN  
● = FD. BRASS DISC IN CONCRETE

2894

SURVEY NO. 2894

Survey Narrative To Comply With Paragraph 209.250  
Oregon Revised Statutes

SURVEY FOR: White City Corporation  
White City, Oregon

LOCATION: Tract situated in the Southeast One Quarter  
(1/4) of Section 18, Township 36 South,  
Range 1 West, Willamette Meridian, Jackson  
County, Oregon.

PURPOSE: To monument and describe the tract indicated  
on the attached map.

PROCEDURE: Bearings and control from Recorded Survey No.  
1894 was used and the monuments were found as shown on the  
attached map. This control has been established and described  
in other surveys made by this office in the same vicinity.

September 18, 1965



J. A. Hoffbuhr  
Registered Land Surveyor

