

Survey No. 2921

Survey Narrative to comply with O. R. S. 209-250:

Survey for: W. Neal

Survey by: Edward A. McGinty, L.S.
August, 1965

BASIS OF BEARING: Previous survey for C. Hoover

PRECEDENCE OF SURVEY:


Found a 5/8" iron pin set on previous survey for C. Hoover (approx flush with surface).

At request of the client set 5/8" x 24" iron pin flush with the surface.

Description were prepared for possible land transaction.



65-40

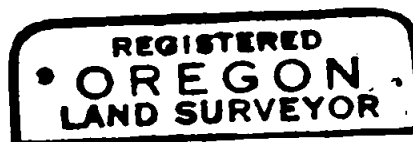

Edward A. McGinty
JULY 10 1953
EDWARD A. MCGINTY
301