

REGISTERED  
**OREGON**  
 LAND SURVEYOR  
*C. Lind McBeth*  
 JANUARY 12, 1962  
 C. LIND MCBETH  
 565

RECEIVED  
 JACKSON  
 NOV 23 1965  
 S. COUNTY  
 SURVEYOR

NOTE:  
 SET PINS ON RECORD DISTANCE  
 NORTH & SOUTH & SET ON PROP-  
 PORTIONAL EAST & WEST.  
 • = SET 5/8" I. PINS

SURVEY FOR: CRATER MUSIC CO.  
 LOTS 2,3,4,5 & 15 BLOCK 4  
 BERRYVALE ADD'N  
 TO MEDFORD  
 BY: C. LIND MCBETH L.S.  
 JACKSONVILLE, OREGON  
 SCALE 1"=100' MARCH 3, 1965

2923

Survey No.-----

Survey Narrative to comply with O.R.S. 209-250

Survey For: Crater Music Company

27 N. Fir

Medford, Oregon


Purpose of Survey: To establish corners of Lots 2, 3, 4, 5, & 15,  
Block 4, Berryvale Addition.

Survey Location: Block 4, Berryvale Addition to City of Medford.

Date: March 10, 1965

Basis of Bearing: Recorded Plat, Berryvale Addition.

Survey Procedure: I Set up the centerline of Loder Ave. from pipes found according to previous surveys in the area. Then chained the East-West distance between the centerlines of Walnut (vacated) and Birch streets. Finding same to be different than that of record, I proportioned my East-West control from the centerline of Walnut to the centerline of Lynn; ( 100' record--99.95' actual); establishing the centerline of Lynn St. I surveyed the Lots as shown on the accompanying plat.

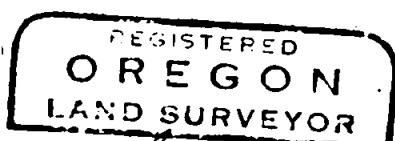

*C. Lind McBeth*  
JANUARY 12, 1962  
C. LIND MCBETH  
563

