

REGISTERED  
OREGON  
LAND SURVEYOR

*L. E. Ager*

MARCH 10, 1944  
L. E. AGER  
21

SURVEY FOR: LAWRENCE OFFICER  
1211 PARK ST., ASHLAND, OREGON  
LOCATION

N.E.N.W. SEC. 5, T. 40 S., R. 2 E., W.M.  
E.S.E. SW. SEC. 32, T. 39 S., R. 2 E., W.M.  
DATE: AUGUST, 1965  
SCALE: 1" = 200'

- = MON. FOUND AS DESCRIBED
  - =  $\frac{5}{8}$ " IRON RODS SET
- DATUM: SOLAR

Survey No. 2930

SURVEY NARRATIVE TO COMPLY WITH O.R.S. 209.250

FOR: Lawrence Officer, 1211 Park Street, Ashland, Oregon.

LOCATION : N.E.  $\frac{1}{4}$  of N.W.  $\frac{1}{4}$  of Section 5, T. 40 S., R. 2 E., W.M. &  
S.E.  $\frac{1}{4}$  of S.W.  $\frac{1}{4}$  of Section 32, T. 39 S., R. 2 E., W.M.


PURPOSE: To monument the boundaries of tracts shown on map.

Procedure: Began survey at the southwest corner of tract previously surveyed, which corner bears North  $63^{\circ}30'$  East 1329.7 feet and South  $32^{\circ}32'$  West 921.40 feet from the Southwest corner of Section 32, Township 39 South, Range 2 East, W.M.; thence monumenting the boundaries of adjoining tracts shown on map and tying this survey to the Northwest corner of Donation Land Claim No. 39 in Township 40 South, Range 2 East, W.M.

Solar taken at 9:15 A.M. Tuesday, August 17, 1965

Sun Decl. =  $13^{\circ}20.4'$  Adjusted Vert. angle =  $39^{\circ}55'$

Latitude =  $42^{\circ}07'$  Computed Sun bearing =  $S.69^{\circ}27'30''E.$

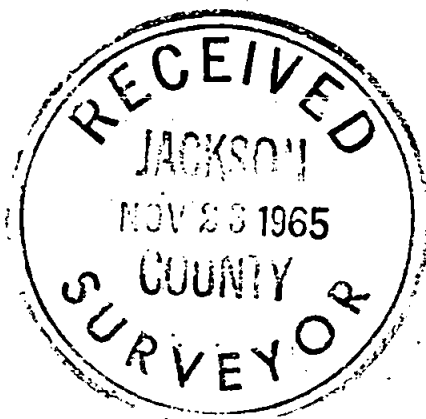

*L. E. Ager*  
MARCH 10, 1964  
L. E. AGER  
21