


Survey For:  
 JOE D. ALLISON  
 Located in the North-Half  
 of Sec. 2, T37SR4W, W.M.  
 By: Mark E. Boyden  
 Dec. 2, 1965

2939

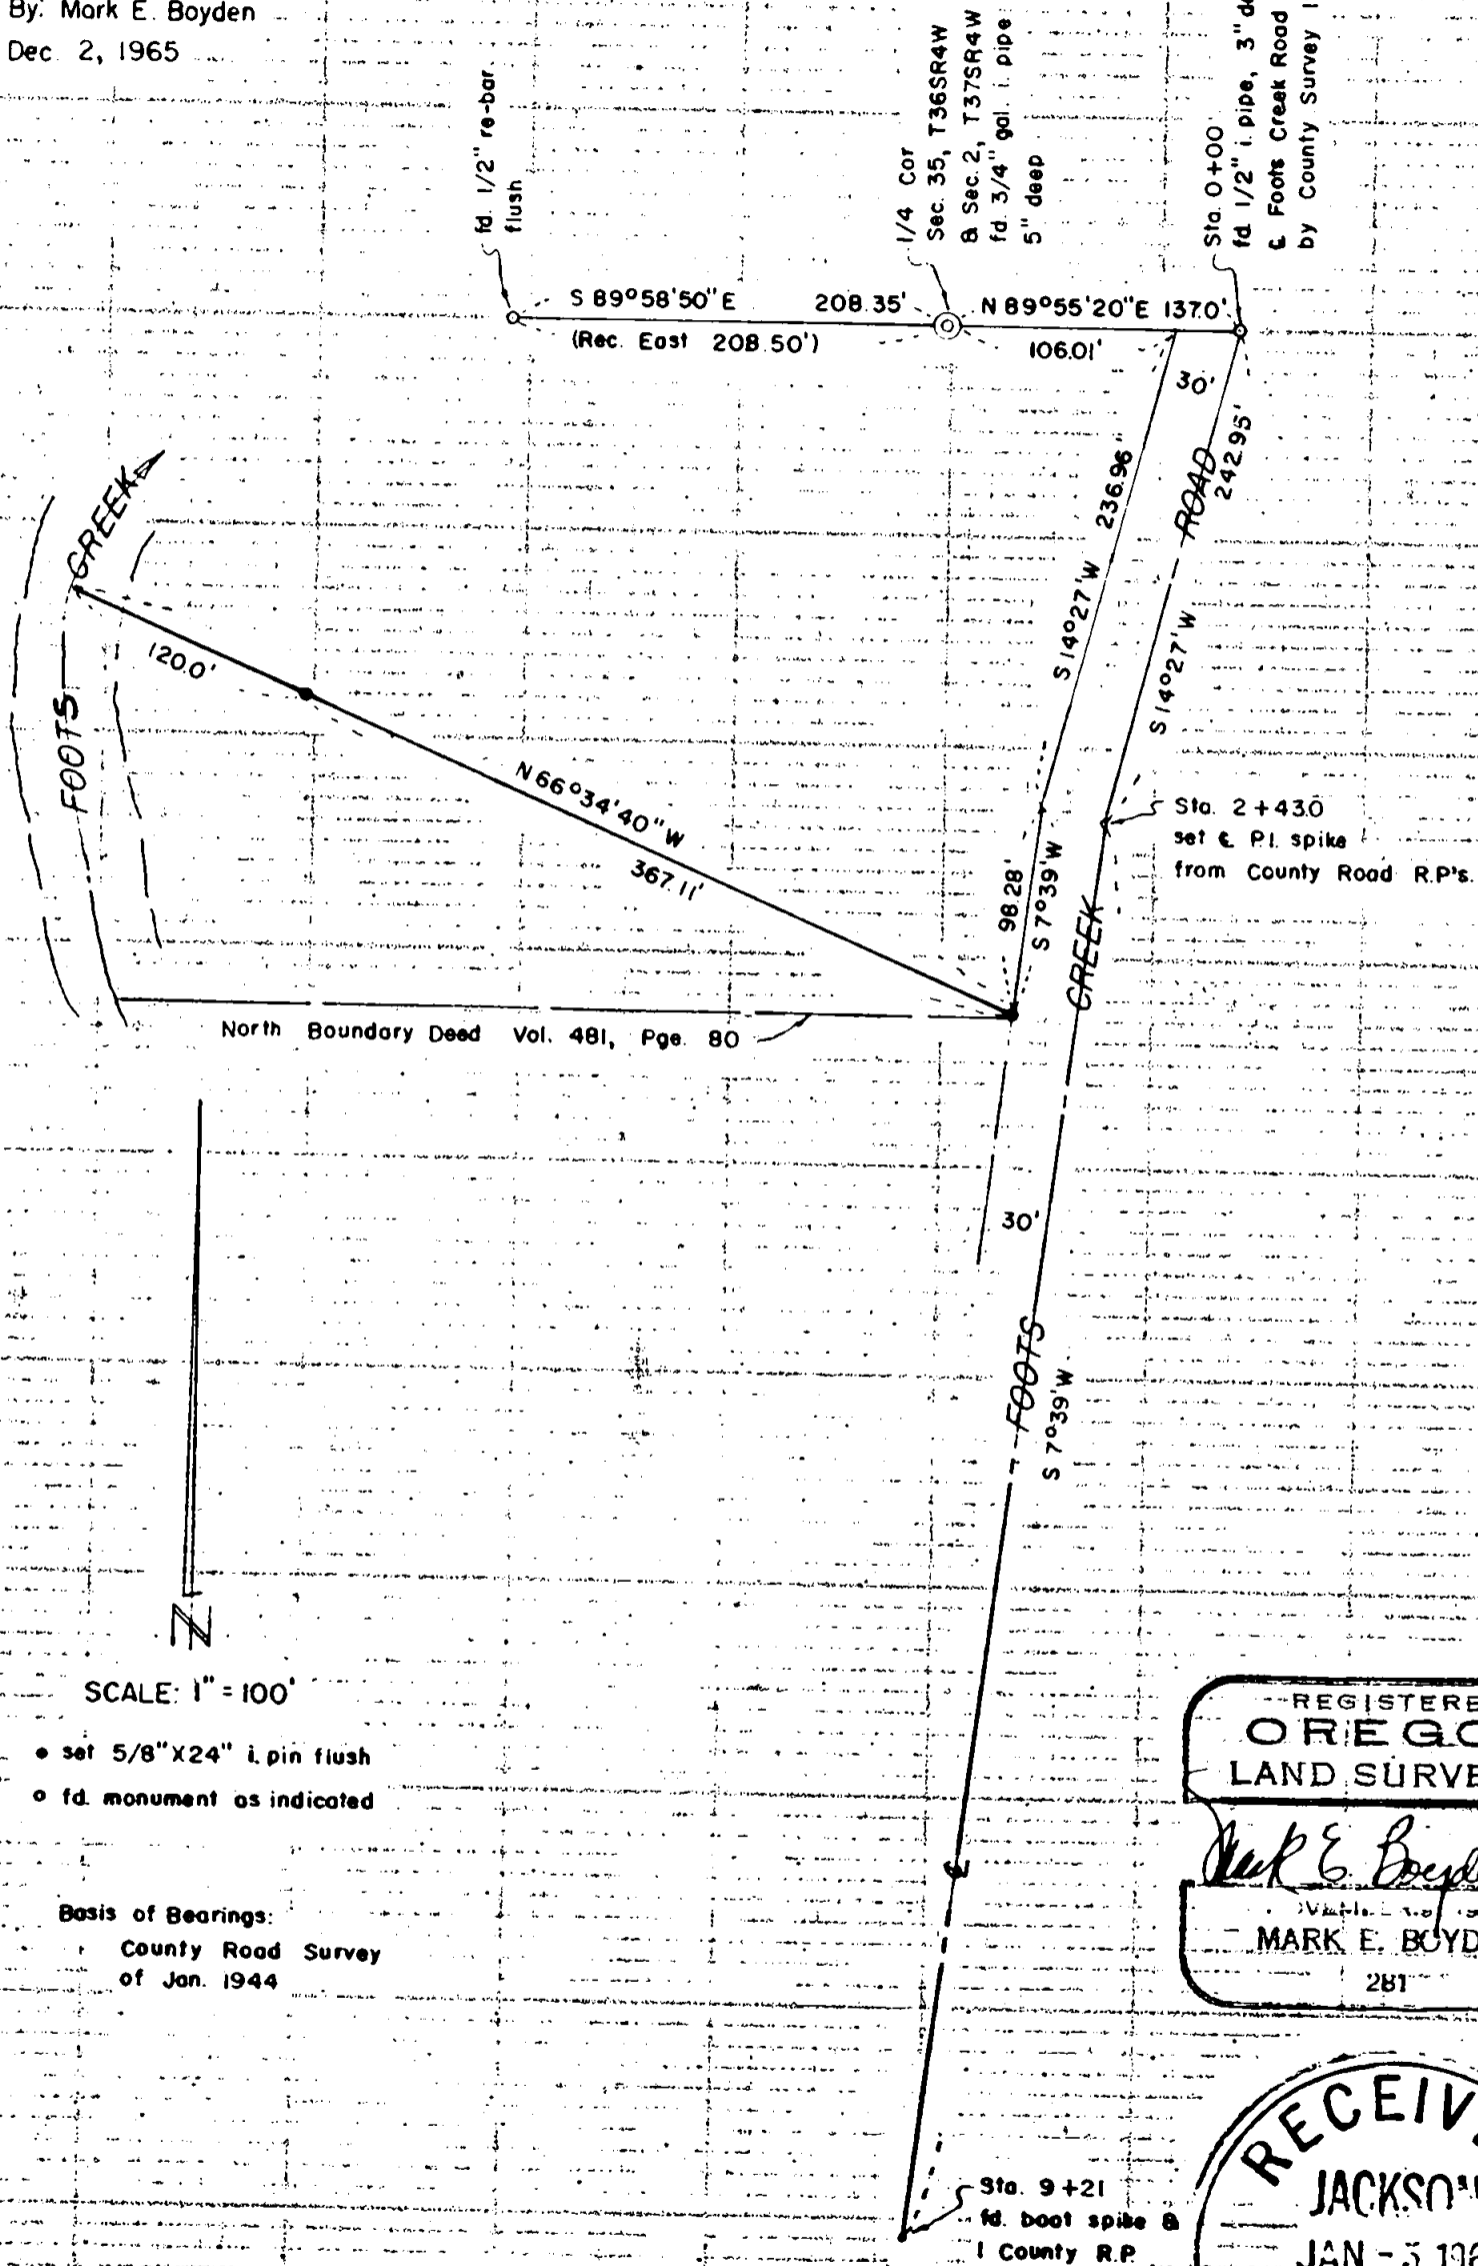

SCALE: 1" = 100'

- set 5/8" x 24" i. pin flush
- fd. monument as indicated

Basis of Bearings:  
 County Road Survey  
 of Jan. 1944

REGISTERED  
**OREGON**  
 LAND SURVEYOR  
*Mark E. Boyden*  
 MARK E. BOYDEN  
 281

RECEIVED  
 JACKSON  
 JAN - 5 1965  
 S. COUNTY  
 SURVEYOR

2939

SURVEY NARRATIVE TO COMPLY WITH O.R.S. 209.250  
REVISED BY CHAPTER 555, O.L. 1963

FOR: Joe D. Allison  
Foots Creek Road  
Gold Hill, Oregon

PURPOSE: To monument the Northeasterly boundary and prepare a legal description of a triangular tract proposed to be conveyed by Allison to Cowie.

PROCEDURE:

From the county road survey controls found as set in 1944, ran from the re-established North quarter corner of Section 2, Township 37 South, Range 4 West to and along the agreed-upon division line.

No monuments could be found for control of the North boundary of Lot "H", FOOTS CREEK PARK (unrecorded), also being described in Deed Volume 481, Page 80 and shown surveyed on Recorded Survey No. 2933.

To re-establish the position of this line, record angles and distances from the North quarter corner of Section 2 were utilized using as a basis of bearing control for FOOTS CREEK PARK, the monumented North boundary of Lot "G" lying Westerly from said quarter corner.

December 2, 1965

