
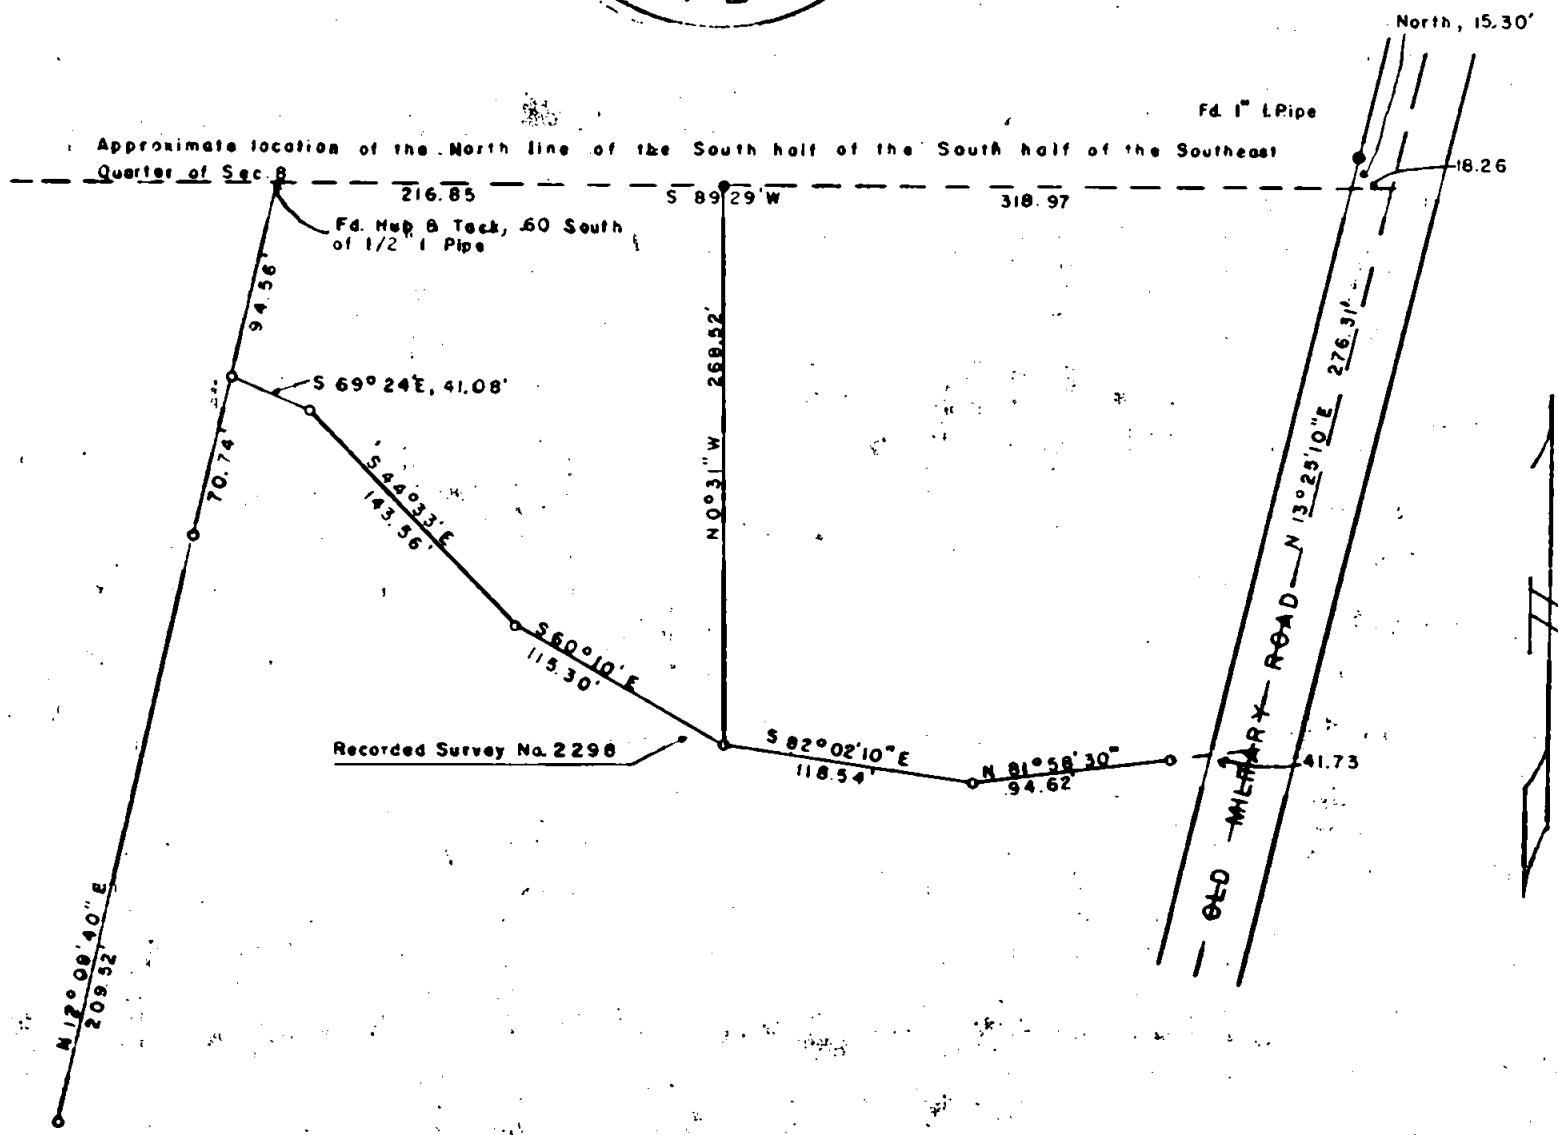
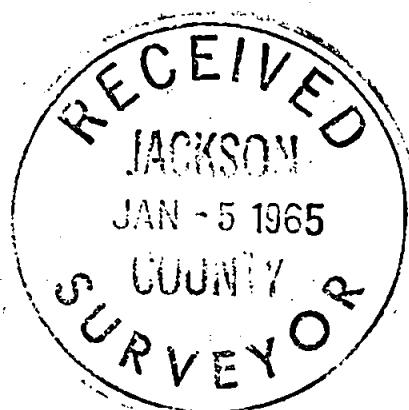


2951

Survey For
ALFRED MOWRY
 Located in Section 8, T 37 S R 2 W, W.M.
 By: Verlyn Thomas
 Oct. 23, 1965

Scaled: 1" = 100'

- Fd. 5/8" L. Pin
- Set 5/8" L. Pin

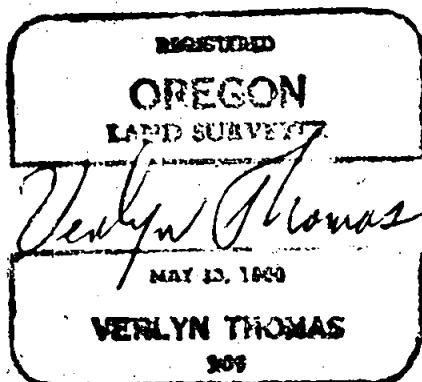

Survey No.

2951

SURVEY NARRATIVE TO COMPLY WITH O.R.S. 209.250
REVISED BY CHAPTER 555, O.L. 1963

FOR: Alfred Mowry
3125 Old Military Road
Medford, Oregon

PURPOSE: To Survey and monument a parcel of approximately 1 acre.

PROCEDURE: Survey No. 2298 was found to circumscribe the original parcel. Monuments from this survey were all found, including a hub and tack at the Northwest corner. A $\frac{5}{8}$ " Iron pin was set at the point indicated on the plat for the Northeast corner of the said new tract.

