

2952

(1) NW Cor. D.L.C. 56

PINE ST. EXT.

(5) Wit. Cor.

179.49'
N 0° 02' 30" E

(4) 83.45'

257.40'
N 89° 57' 30" W

(3)

370.26'

S 0° 02' 30" W

BIGHAM LANE

FREEMAN

RECEIVED
JACKSON
JAN - 5 1965
COUNTY
SURVEYOR

OAK ST.

(2) Fd. 5/8" I. Pin.



REGISTERED
OREGON
LAND SURVEYOR

Edward A. McGinty

JULY 10, 1953
EDWARD A. MCGINTY
301

Survey in the SW 1/4 Sec. 2, T.37S., R.2W., W.M.
for

C. ALLEMAN
65-33

By Edward A. McGinty
Medford, Oregon

Scale 1" = 100'
• 5/8" I. Pin


2952

Survey No. 2952

Survey Narrative to comply with O.R.S. 209-250:

Survey for: Mr. C. Alleman
401 Crater Lake Ave.

Survey by: Edward A. McGinty, L.S.
May, 1965 En

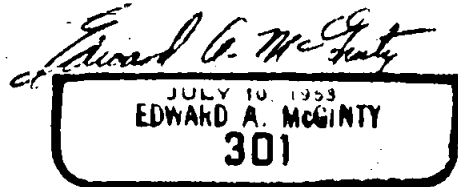


BASIS OF BEARING: Previous survey No. 482.

PRECEDENCE OF SURVEY:

Monuments:

1. Found a brass cap monument, flush with pavement, Mkd. NW cor. DLC 56.
2. Found a 5/8 in. iron pin, flush with the pavement.
3. Set a 5/8 inch iron pin, 24 ins. long, flush
- 4 & 5. A 5/8 in. iron pin set flush, as witness corner.

From descriptions furnished, surveyed tract, held 90°00' (deed record angle) from center line of Freeman Rd.

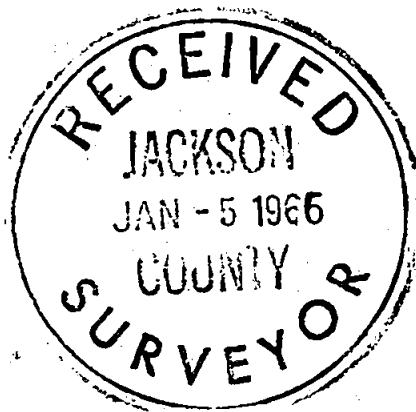

65-33