

SURVEY FOR LOYD ARNOLD

N.E. 1/4 Sec. 5, T.36S. R.1W., W.M.

Jackson County Oregon

October 1965



Scale 1" = 200'

Fd. 3/4" I. Pipe

Rec Survey No. 2426

N 89°59'50"W 1329.56

Mea 1330.11

665.05

32

5

33

4

Fd. 1 1/4 I. Pipe

Set 5/8x24" I. Pin

REGISTERED
OREGON
LAND SURVEYOR

Verlyn Thomas

MAY 12, 1960
VERLYN THOMAS
509

RECEIVED
JACKSON
JAN 26 1966
COUNTY
SURVEYOR


Survey No. 2971

SURVEY NARRATIVE TO COMPLY WITH O.R.S. 209.250
REVISED BY CHAPTER 555, O.L. 1963

FOR: Loyd Arnold
2454 Corona Ave.
Medford, Oregon

PURPOSE: Determine Northeast property corner.

PROCEDURE: Traversed between Section corner common to Sections 32, 33, 4, and 5,
and the $\frac{3}{4}$ " Iron pipe set in Recorded Survey No. 2426, as shown on
the accompanying plat. Set $\frac{5}{8}$ " Iron pin at midpoint.

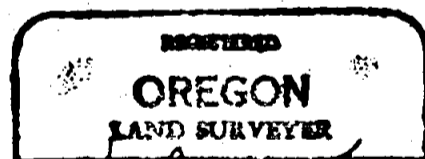

Verlyn Thomas

