

2978

SURVEY FOR JOHN ROSS
Attorney at Law


In Block 8, Original Townsite
of
Gold Hill, Oregon

January 5, 1966



Scale 1" = 20'

- Found 1. Pin
- 5/8 x 24" 1. Pin set flush

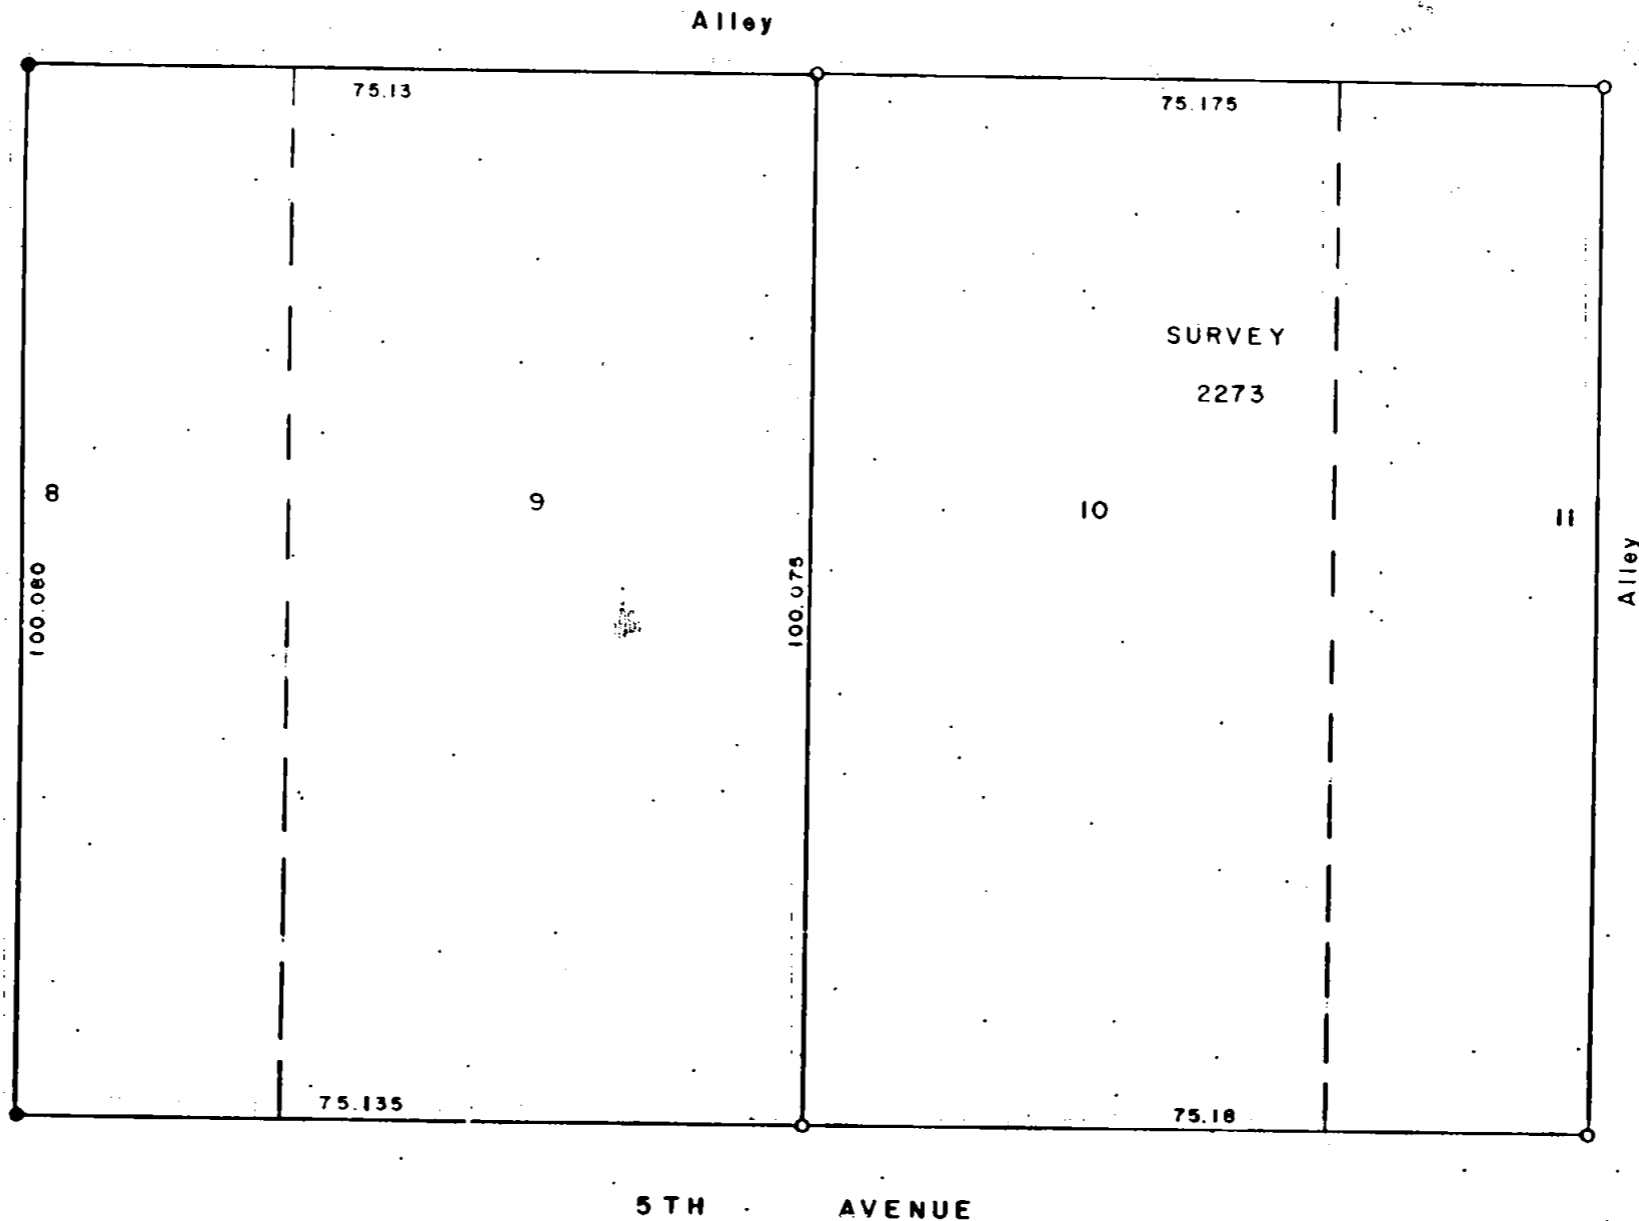

REGISTERED
OREGON
 LAND SURVEYOR

Verlyn Thomas

MAY 13, 1966

VERLYN THOMAS
 505

2978

Survey No. 2978

SURVEY NARRATIVE TO COMPLY WITH O.R.S. 209.250
REVISED BY CHAPTER 555, O.L. 1963

FOR: John Ross, Attorney at Law
Fluhrer Building
Medford, Oregon

PURPOSE: Monument Lot 9, and the easterly 25 feet of Lot 8, Block 8, in
Gold Hill.

PROCEDURE: A search of recorded surveys produced Survey No. 2273, which
monumented the easterly line of Lot 9, and set forth the proport-
ional dimensions for the block. Monumented Lot lines per Survey
2273 were extended westerly the recorded distances, and monumented
as shown on the accompanying plat.

