



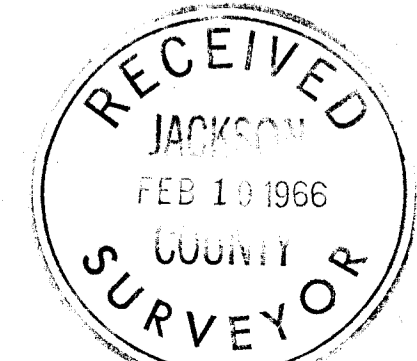

STAGE COACH RANCHOS  
 SURVEY IN SEC. 27, T36S, R3W.  
 FOR  
 FAYDREX, INC.

BY EDWARD MCGINTY SCALE 1"=200'  
 MEDFORD OREGON 5/8" IRON PIN  
 AUGUST 1965  
 REV. DEC 1965

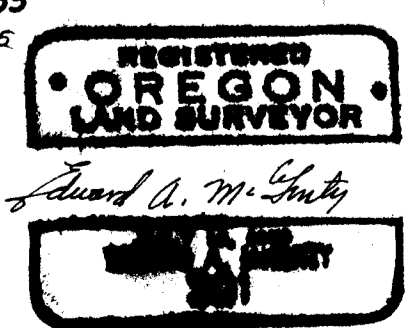

(Sheet two of two sheets)

Survey No. 2984

Survey for: Faydrex, Inc.



Survey by: Edward A. McGinty

The approx. north line of Sec. 27 was determined by ties to previous survey, near freeway, by L.P. Lovejoy which tied to the N.W. cor. of DLC 37 and using a porportional distance along the west line of DLC 37. Set the approx. NE. cor. of Tract 31. The same porportional distance along the west line of DLC 37 was used to determine approx. north 1/4 cor. This was used in the tie to the South 1/4 cor. to determine the approx. east boundary of Tract 20-1.

Caution to owners, surveyors or interested parties. This survey was, in part, a re-survey. The previous survey was made by an Engineer and is unrecorded, a large numbe of iron pins were set on previous survey, near and in some cases at some distance from monuments which were set on this survey. Most of the monuments set on previous survey were 1/2 in. and 3/4 in. re-inforced steel.

Note, new descriptions have been prepared for clients, bases on this re-survey.

64-36

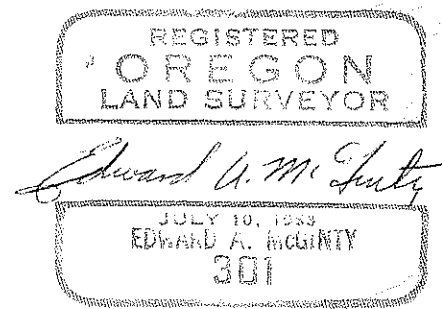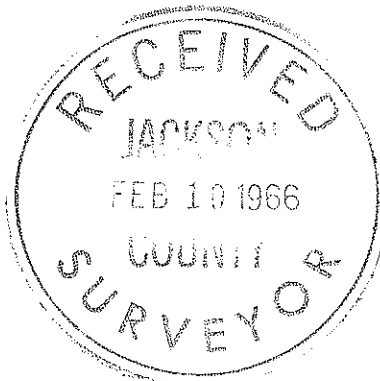

Survey Narrative to comply with O. R. S. 209-250.

Survey for: Faydrex, Inc.  
1054 So. Riverside Ave.

Survey by: Edward A. McGinty, L.S.

BASIS OF BEARING: Survey No. 604.

PRECEDENCE OF SURVEY:

Monuments:

- A. Found a  $1\frac{1}{2}$  in. iron pipe, 6 ins. high, mkd. Sec. cor., set by County surveyor.
  - B. Found a 7 in. x 8 in. x ? - 5 ins. high, 3 notchs on east face,  $1/4$  cor. on west face.
  - C. Found a wood stake, replaced it with a  $5/8$  in. x 20 in. iron pin, from which
    - Face of old blaze, on white oak, 12 ins. diam., bears S.  $36\frac{1}{4}^{\circ}$  W., 8.58 ft.
    - Face of old blaze on white oak, 14 ins. diam., bears N.  $64\frac{1}{4}^{\circ}$  W., 13.20 ft.
    - Center of white oak, 3 ins. diam., bears N.  $23\frac{1}{4}^{\circ}$  E., 11.1 ft.
    - Center of white oak, 12 ins. diam., bears S.  $25\frac{1}{2}^{\circ}$  W., 42.0 ft.
  - D. Set a  $5/8$  x 20 in. iron pin, from which
    - A fir, badly decomposed, with apparent old blazes, bears N.  $15^{\circ}$  W., 13.20 ft.
    - Center of black oak, 5 ins. diam., bears S.  $2^{\circ}35'$  W., 29.8 ft.
    - Center of black oak, 6 ins. diam., bears N.  $83^{\circ}40'$  E., 38.6 ft.
  - E. Found a  $1\frac{1}{2}$  in. iron pipe, flush with the surface.
  - F. Found a  $1\frac{1}{2}$  in. iron pipe, flush with the surface.
  - G. Found a wood hub, set by Mr. Hugh Ingle, set a  $5/8$  in. iron pin.
  - H. Found a 1 in. iron pipe, 12 ins. above the surface.
  - I. Found a  $1\frac{1}{4}$  in. iron pipe, flush with the surface.
  - J. Found a  $3/4$  in. iron pipe, flush with the surface.
  - K. Found a spike
  - L. Found a  $5/8$  in. iron pin, 6 ins. above the surface, in the gutter.
  - M. Found a  $3/4$  in. iron pipe, flush with the surface.
  - N. Found a  $1\frac{1}{2}$  in. iron pipe
  - O. Found a  $1/2$  in. iron pin.
  - O-1 Found a  $1/2$  in. iron pin, 6 ins. deep
  - P. Set a  $5/8$  in. iron pin, 4 ins. deep
  - Q. Set a  $5/8$  in. iron pin, offset 32.00 ft. from center line
  - R. Found a  $3/4$  in. iron pin.
- All monuments set being  $5/8$  in. X 20 in. iron pins, set approx. flush with surface. except as otherwise designated.