

Survey No. 2985

Jackson County Surveyor  
Mr. Mark Boyden  
Medford, Oregon  
December, 1965

Corner reference to a BLM corner monument marked center Section 27, T35S, R2E, 1962, was removed during logging operations. (note, corner monument not officially approved, nor of County records).


Reset standard BLM corner monument, in its original location, from which

Found a douglas fir, 12 ins. diam., bears N.  $65\frac{1}{2}^{\circ}$  W., 24.42 ft.

Found an uprooted fir, 10 ins. diam., moved from its original location during logging, called for S.  $51^{\circ}$  W., 24 lks.

New tree,

A fir, 8 ins. diam., bears S.  $61^{\circ}$  W., 13.78 ft. distance, scribed C 1/4 S 27 BT.

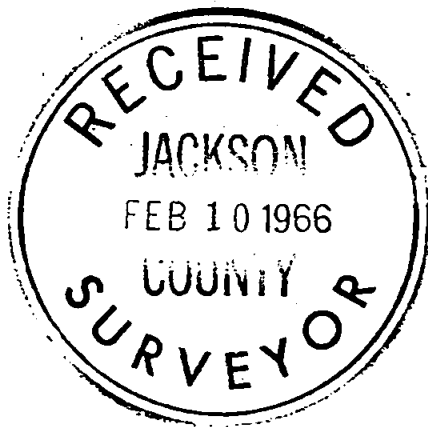

*Edward A. McGinty*



EM/HM