

SURVEY IN BLK. 2 CITY OF JACKSONVILLE
 LEWIS SUB'D FOR
 WARREN MEE
 65-47 31

BY EDWARD MCGINTY
 MEDFORD OREGON
 JULY 1965

SCALE 1" = 100'
 O = 5/8" I. PIN SET
 ● = 5/8" I. PIN FD.

REGISTERED
 OREGON
 LAND SURVEYOR

Edward A. McGinty

JULY 10, 1953
 EDWARD A. MCGINTY
 301

RECEIVED
 JACKSON
 FEB 10 1966
 COUNTY
 SURVEYOR

Survey No. 2988

Survey Narrative to comply with O. R. S. 209-250:

Survey for: Warren Mee
Foothills Road


Survey by: Edward A. McGinty, L.S.
July 1965

BASIS OF BEARING: Previous survey for Ed Holley


PRECEDENCE OF SURVEY:

Monuments found being 5/8 inch iron pins approximately
flush being record in the survey for Ed Holley.

Monuments set being 5/8 inch iron pins set approximately
flush at the Northwest and Northeast corner of Lot 5.

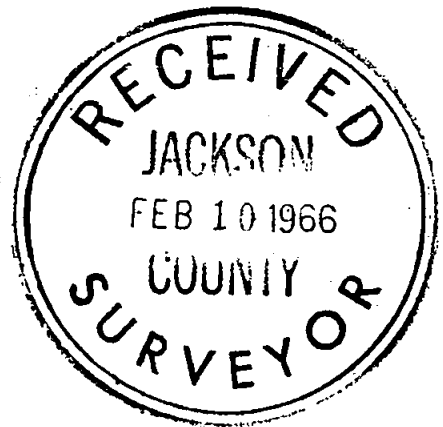

Edward A. McGinty

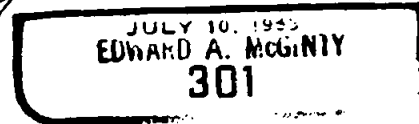

65-47