

2993



NE COR
DLC 49

(C)
729.70'
S 89° 53' 50" E

Voorhies Road

(D)
170.50'

N 0° 11' 30" W 960.30'

(B)

315.92' 644.21'

285.93'
S 0° 26' 30" W

S 89° 56' 50" E
144.0'

S 89° 56' 50" E
848.90'

Carpentier Hill Road

SEE N.A.R.

N 89° 33' 25" W
994.65'



200.00'

923.36'
N 0° 12' 00" W

200.06'

FD.
(A)

SUR. NO. 2905

FD.
(A)



Edward A. McGinty



SURVEY IN SEC 8, T38S, R1W, WM
FOR
A. C. LEWIS
65-37

BY EDWARD MCGINTY
MEDFORD OREGON
DECEMBER 1965

SCALE 1" = 200'
○ = 5/8" IRON PIN

2993

Survey No. 2993

Survey Narrative to comply with O.R.S. 209-250:

Survey for: A. C. Lewis
Coleman Creek Rd.

Survey by: Edward A. McGinty, L.S.
December 1965

BASIS OF BEARING: Previous survey for C. Wolf


PRECEDENCE OF SURVEY:

Monuments:


- (A). Found 5/8 inch iron pin, see survey no. 2905.
- (B). Found spike on center line.
- (C). Found brass capped pipe flush with pavement.
- (D). Found Co. P.I. 1/2 inch pipe approximately 4 inches deep.
- (E). Found 5/8 inch bolt 4 inches deep more or less.

All monuments set on this survey being 5/8 x 20 inch iron pins set approximately flush with surface.

Northerly line of the larger tract is proposed only.

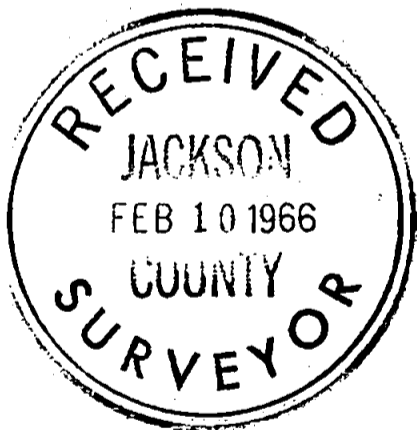

Edward A. McGinty

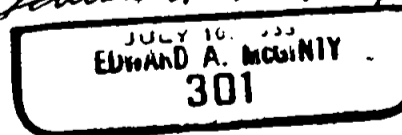

65-37