

REGISTERED  
**OREGON**  
 LAND SURVEYOR  
*J. A. Hoffbuhr*  
 NOVEMBER 7, 1947  
**J. A. HOFFBUHR**  
 222

**MAP OF SURVEY**

LOCATED IN

SE 1/4 OF SW 1/4 & SW 1/4 OF SE 1/4 OF SEC. 25  
 NE 1/4 OF NW 1/4 & NW 1/4 OF NE 1/4 OF SEC. 36  
 T. 38 S. R. 1 W., W.M.

JACKSON COUNTY OREGON  
 FOR

MELVIN FELLOWS & EDWARD G. MELICKE

J.A. HOFFBUHR L.S. MEDFORD, OREGON  
 SCALE 1"=100' MARCH 30, 1965

BEARINGS PER SURVEY NO. 2025

- FOUND 5/8" BOLT
- SET 5/8" IRON PINS
- ⊠ FOUND 2" GALVANIZED IRON PIPE WITH 3/4" IRON PIPE INSIDE
- ✱ EXISTING FENCE


Survey Narrative To Comply With Paragraph 209.250  
Oregon Revised Statutes.

SURVEY FOR: Melvin Fellows  
2958 Diane Street  
Ashland, Oregon.  
and  
Edward G. Melicke  
Talent, Oregon.

LOCATION: The tracts are situated in the South One Half  
(1/2) of Section 25 and the North One Half (1/2)  
of Section 36, Township 38 South Range 1 West,  
Willamette Meridian, Jackson County, Oregon.

PURPOSE: To monument the boundaries and describe the  
tract as shown on the attached map.

PROCEDURE: The controls established by Recorded Survey No.  
2886 were used to establish the Westerly and Southerly line of  
the Fellows tract as shown by the attached map. Basis of bearings  
Recorded Survey No.2025.  
January 27, 1966

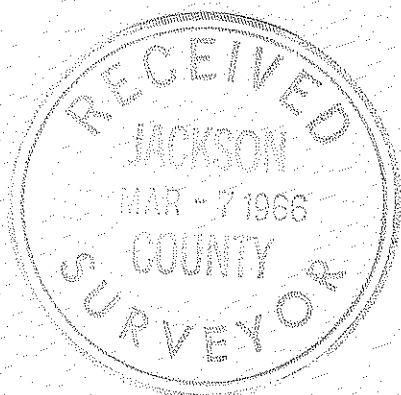

J. A. Hoffbuhr  
Registered Land Surveyor

