

1/4 SEC. COR.
FD. BRASS DISC



INSERT SCALE: 1" = 40

MAP OF SURVEY

LOCATED IN
N.W. 1/4 OF SEC. 5, T.37S., R.1W., W.
JACKSON COUNTY OREGON

FOR
W.L. BRYANT
J.A. HOFFBUHR L.S. MEDFORD, OREGON
SCALE: 1" = 300' AUGUST 19, 1965


BEARINGS PER RECORDED SURVEY
NO. 2775
○ = SET 5/8" X 24" REINF. PIN

C.N. 1/16 SEC. COR.
SET 5/8" X 30" REIN.
PIN

N. 1/16 SEC. COR.
SET 5/8" X 30" REINF. PIN

REGISTERED
OREGON
LAND SURVEYOR

J. A. Hoffbuhr
NOVEMBER 7 1965
J. A. HOFFBUHR
222

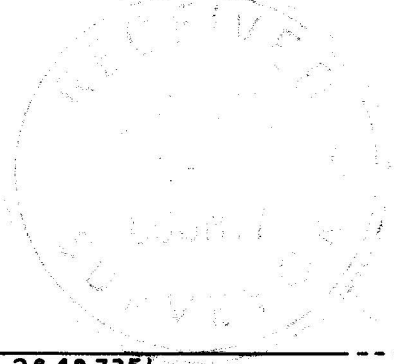

EAST 3000'
FD. 3/4" I. BOLT
WITNESS COR.

Survey Narrative To Comply With Paragraph 209.250
Oregon Revised Statutes


SURVEY FOR: W.L. Bryant
1816 East Vilas Road
Medford, Oregon

LOCATION: Tract situated in the Northwest One Quarter (1/4)
of Section 5, Township 37 South, Range 1 West
Willamette Meridian, Jackson County, Oregon.

PURPOSE: To monument the corners and describe the tracts of
land shown on the attached map.

PROCEDURE: The Section was subdivided and the corners found
are as shown on the map. The tracts were monumented also as in-
dicated. Basis of bearings Recorded Survey No.2775.

W. L. Bryant
January 31, 1966

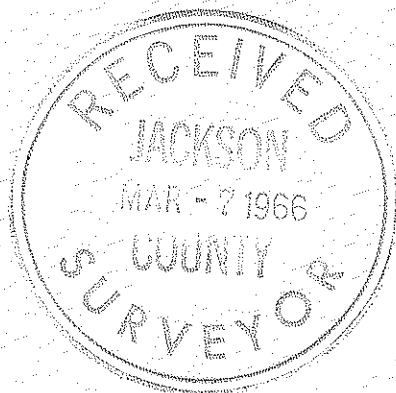

J. A. Hoffbuhr
Registered Land Surveyor

