

REGISTERED
OREGON
 LAND SURVEYOR
J. A. Hoffbuhr
 NOVEMBER 7, 1947
 J. A. HOFFBUHR
 222

MAP OF SURVEY

SITUATE IN
 LOT 2 BLOCK 3 PALMS SECOND
 ADDITION TO THE CITY OF MEDFORD
 JACKSON COUNTY OREGON
 FOR
 M.E. MORSE
 J.A. HOFFBUHR L.S. MEDFORD ORE.
 SCALE: 1"=40' 9-28-1965

BEARINGS PER REC. SURVEY NO. 1920
 ○ = SET 5/8" X 24" REINF. PIN
 X = FD. 5/8" I. PIN
 ● = FD. NAIL SET ON SURVEY NO. 1920

FD. SPIKE & SHINER
 FD. 2" BRASS DISC W/ "X" & E PUNCH
 IN IRON MON. WELL

3018 FD. 2" BRASS DISC IN CONC. BRIDGE N.N.E. COR. D.L.C. NO. 42

Survey Narrative To Comply With Paragraph 209.250
Oregon Revised Statutes


SURVEY FOR: M. E. Morse
1511 North Riverside
Medford, Oregon.

LOCATION: Lot 2 Block 3, Palms Second Addition to the
City of Medford.

PURPOSE: To monument the line indicated on the attached
map.

PROCEDURE: Survey control used is as indicated on the
attached map and as used for Recorded Survey No. 1920. Bearings
as per the above survey.

December 17, 1965

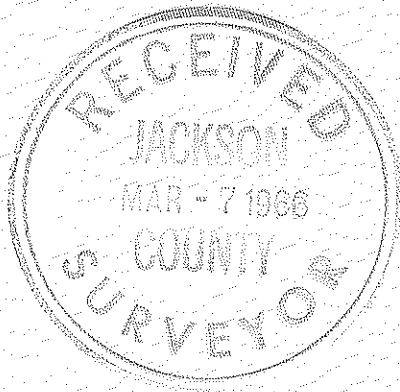

J. A. Hoffbuhr
Registered Land Surveyor

