

**SURVEY FOR**  
 Mrs. E. B. Blevins  
 Located in D.L.C. #37,  
 in the South half of  
 Section 2, T. 39 S. R. 1 W., W.M.  
 by  
 George R. Burrell  
 Feb. 15, 1966  
 Bearings per Survey #1903

REGISTERED  
**OREGON**  
 LAND SURVEYOR  
 George R. Burrell  
 JULY 10, 1964  
 GEORGE R. BURRELL  
 638




3027


easterly R/W line of Wagner Creek county road as I establish it from the existing center line of Wagner Creek county road, I then establish the bearing of the division line as per the sale agreement and monument same as shown on the survey map.

February 15, 1966

George R. Burrell  
Registered Land Surveyor

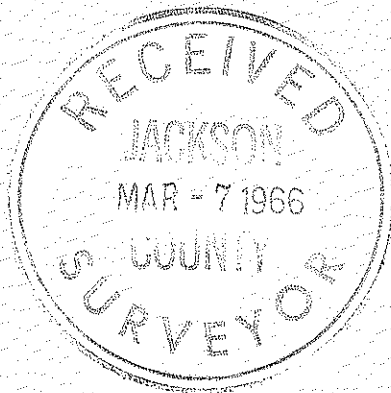

*George R Burrell*

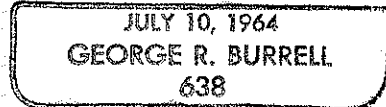

Survey Narrative to Comply with Paragraph 209.250  
Revised by Chapter 555, O.L. 1963

SURVEY FOR: Mrs. E.B. Elevins  
Talent, Oregon

LOCATION: Tract situated in Donation Land Claim 37; Section 2, Township 39 South, Range 1 West, Willamette Meridian in Jackson County, Oregon.

PURPOSE: To establish a division line set forth by sale agreement to originate at the intersection of the center line of Wagner Creek and the east right of way line of Wagner Creek county road and terminate at a point near the Talent Irrigation District irrigation ditch on the north boundary of parcel III as recorded in volume 504, page 222 of the Deed Records of Jackson County, Oregon, thus severing that portion of parcel III lying north of Wagner Creek county road and east of the division line thus established. Also to provide description of above mentioned severed parcel.

PROCEDURE: Found D.L.C. corner monuments and a monument at the intersection of the east line of D.L.C. #37 and the easterly R/W line of Wagner Creek county road. Since no monument exists at the N.E. corner of parcel III and further that the fence on the north line of occupation of parcel III was found to disagree substantially with the deed record, my original intent of reestablishing the north boundary of parcel III was abandon as the owner did not wish to participate in the cost of the survey required. Original intentions to establish, reestablish and monument all corners of the severed tract were abandon and attention directed solely to the requirements of the sale agreement. For this purpose, I traversed from the S.E. corner of D.L.C. #37 to the intersection of the center line of Wagner Creek and the