

3040

FOUND PROPERTY PIN
AS PER R/S NO. 1349

R/S NO. 1803

R/S NO. 2732

R/S NO.
1770

94.04

100.00'

50.00'

S 89° 57' 30" W

459.82'

2.00 ACRES

R/S NO. 1349

N 0° 05' 20" W
200.00'

FOUND

FOUND PROPERTY PIN
5/8" IRON ROD

N 89° 57' 30" E

411.40'

FOUND 5/8" IRON PIN

S 13° 41' 40" E
205.82'

BIDDLE ROAD

30'

30'

N

MAP OF SURVEY

LOCATED IN
S.W. 1/4 SEC. 19, T.37 S., R.1 W., W.M.
JACKSON COUNTY OREGON


FOR
A. K. MORSE

J. A. HOFFBUHR, REG. L.S., MEDFORD, OREGON
SCALE, 1" = 50' JANUARY 29, 1965

BASIS OF BEARING - R/S NO. 1349

o = SET 5/8" X 24" STEEL REINF. PIN

3040

 

REGISTERED
OREGON
LAND SURVEYOR

J. A. Hoffbuhr
NOVEMBER 7, 1947
J. A. HOFFBUHR
222

Survey Narrative To Comply With Paragraph 209.250
Oregon Revised Statutes


SURVEY FOR: A.K. Morse
6th and Ivy
Medford, Oregon

LOCATION: Tract situated in Southwest One-Quarter (1/4)
of Section 19, Township 37 South, Range 1 West,
Willamette Meridian, Jackson County, Oregon.

PURPOSE: To monument and describe the tract of land de-
scribed in Jackson County Deed Records Volume
563 Page 335 and also shown on the attached map.

PROCEDURE: The control established for other surveys in the
area was used for this survey. Basis of bearings Recorded Survey
No. 1349.

March 3, 1966

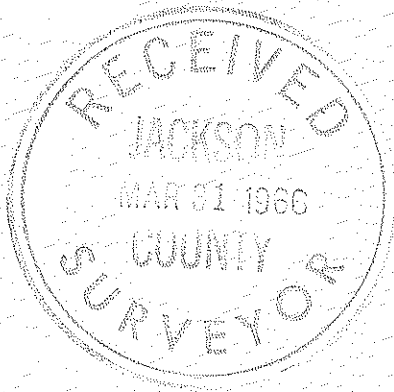

J.A. Hoffbuhr
Registered Land Surveyor

