

MAP OF SURVEY
 LOCATED IN
 LOTS 1 & 2, BLOCK 39 OF ORIGINAL TOWN OF MEDFORD
 JACKSON COUNTY OREGON
 FOR
DON KAHL

REGISTERED
OREGON
 LAND SURVEYOR
J. A. Hoffbuhr
 NOVEMBER 7, 1947
J. A. HOFFBUHR
 222

J. A. HOFFBUHR, REG. L.S., MEDFORD, OREGON
 SCALE, 1" = 60' DECEMBER 27, 1965
 BASIS OF BEARING - REC. SURVEY NO. 138
 ○ = SET 5/8" X 24" STEEL REINF. PIN
 ⊙ = MONUMENT CASE
 ✕ = FOUND MONUMENT

3043

3043


Survey Narrative To Comply With Paragraph 209.250
Oregon Revised Statutes

SURVEY FOR: Don Kahl
501 North Fir
Medford, Oregon

PURPOSE & LOCATION: To monument the corners of Lots 1 and 2,
Block 39, of the original town of Medford.

PROCEDURE: The intersection monuments were found as
shown on the attached map and the distances were verified by other
surveys in the area. Basis of bearings Recorded Survey No. 138.

March 1, 1966

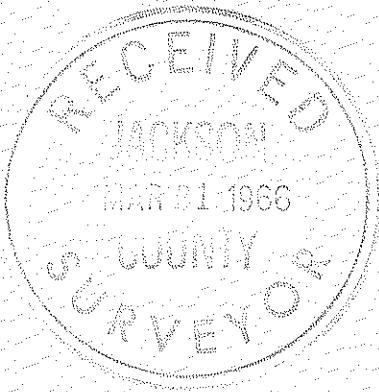

J.A. Hoffbuhr
Registered Land Surveyor

