

3078

MAP OF SURVEY
 LOCATED IN
 NE 1/4, NE 1/4 SEC. 14, T. 36 S., R. 1 W., W. M.
 JACKSON COUNTY OREGON
 FOR
 MAX WOODARD

J. A. HOFFBUHR, REG. L.S., MEDFORD, OREGON
 SCALE: 1" = 200' FEBRUARY 5, 1966
 BASIS OF BEARING - R/S NO. 1292
 o = SET 5/8" X 24" STEEL REINF. PIN
 REVISED FEB. 15, 1966

REGISTERED
OREGON
 LAND SURVEYOR

J. A. Hoffbuhr

NOVEMBER 7, 1947
 J. A. HOFFBUHR
 222

3078


Survey Narrative To Comply With Paragraph 209.250
Oregon Revised Statutes

SURVEY FOR: Max Woodard
C2 Cattle Company
Lake Creek, Oregon

PURPOSE AND LOCATION: To monument and describe that portion of the East One Half (1/2) of the Northeast One Quarter (1/4) of the Northeast One Quarter (1/4) of Section 14, Township 36 South, Range 1 West, Willamette Meridian, Jackson County, Oregon, that lies South-erly of the natural drainage way running through the tract, as shown.

PROCEDURE: The Section line between Sections 11 and 14 was traversed, also a retracement of a portion of Recorded Survey No. 1292 was made to verify the points found, also the bearings and distances shown. From this information the Northeast One Quarter (1/4) of Section 14 was subdivided and the Northeast ONE Quarter (1/4) of the Northeast One Quarter (1/4) was divided as shown. Basis of bearings Recorded Survey No. 1292.

March 24, 1966

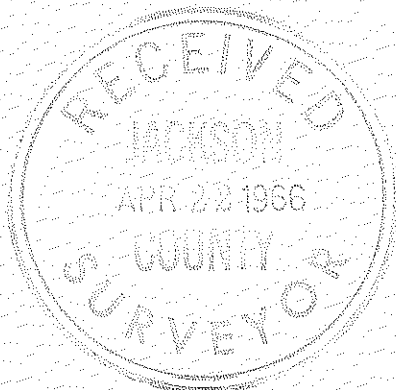

J.A. Hoffbuhr
Registered Land Surveyor

