

3095

NE COR DLC 43
5/8" I. PIN SET IN CHARRED STAKE

DLC 40

DLC 43

50° 08' 40" W

1351.75'

565.00'

C-L CO. RD. S 89° 52' W

586.25'

S 0° 15' W 2.9' R.P.


409.79'

611.35'

1831.50'

NORTH 1.75'

NW. COR.
DLC-42

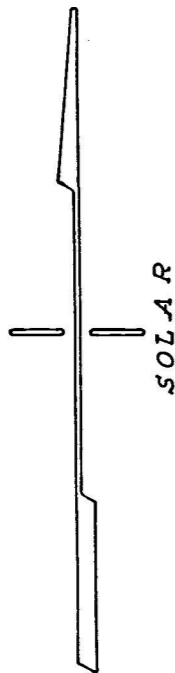

SOLAR

NAIL IN U-WOOD POST

APPROX DLC LINE

NORTH

906.82'

N 89° 20' E

611.39'

356.30'

611.39'

S 89° 20' W

901.13'

871.13'

SOUTH

SURVEY IN SEC. 10, T. 36 S R 2 W W M.

FOR

ED TAYLOR

61-26

BY EDWARD MCGINTY
MEDFORD OREGON
DECEMBER 1961

SCALE 1" = 200'
○ = 1/2" I PIN
⊙ = 1-1/4" PIPE

REGISTERED
OREGON
LAND SURVEYOR

Edward A. McGinty

JULY 10, 1953
EDWARD A. MCGINTY
301

DLC 42

3095

Survey Narrative to comply with O.R.S. 209-250-

Survey for: Ed Taylor
Table Rock Rd., Central Pt.

Survey by: Edward A. McGinty, L.S.
December 1965

BASIS OF BEARING: Solar observation

PRECEDENCE OF SURVEY:

Northwest corner of Donation Land Claim 42 located from a survey for Nealon by L. P. Lovejoy in September 1952 at which time they dug a hole and found remains of a pine stump (Nealon had confirmed that this was the remains of the original BT as seen scribing on it, also found remains of pine roots and stump to the Southeast. A $\frac{1}{2}$ inch iron pin was set.

Note this is now approximately 1.75 of the center line of the New County Rd.

Northeast corner of Donation Land Claim 43 after digging found remains of an old charred stake. Set $\frac{5}{8}$ inch iron pin in the remains of the stake.

Easterly of tract was established by measuring westerly 1831.50 feet from the Northwest corner of Donation Land Claim 42, which was not entirely acceptable by the adjacent owner.

Surveyed tract as requested by client.

Monuments being $\frac{1}{2}$ x 20 inch iron pins (unless otherwise designated) approximately flush with the surface, except for the easterly corner of the southerly tract being 8 inches deep.

