


Survey For:  
 CENTRAL POINT SPORTSMEN'S CLUB  
 Located in LOT "C" Of The  
 COOKSEY ADDITION TO  
 CENTRAL POINT, OREGON  
 BY: MARK E. BOYDEN  
 MAY 16, 1966

REGISTERED  
**OREGON**  
 LAND SURVEYOR  
*Mark E. Boyden*  
 NOVEMBER 9, 1951  
 MARK E. BOYDEN  
 281

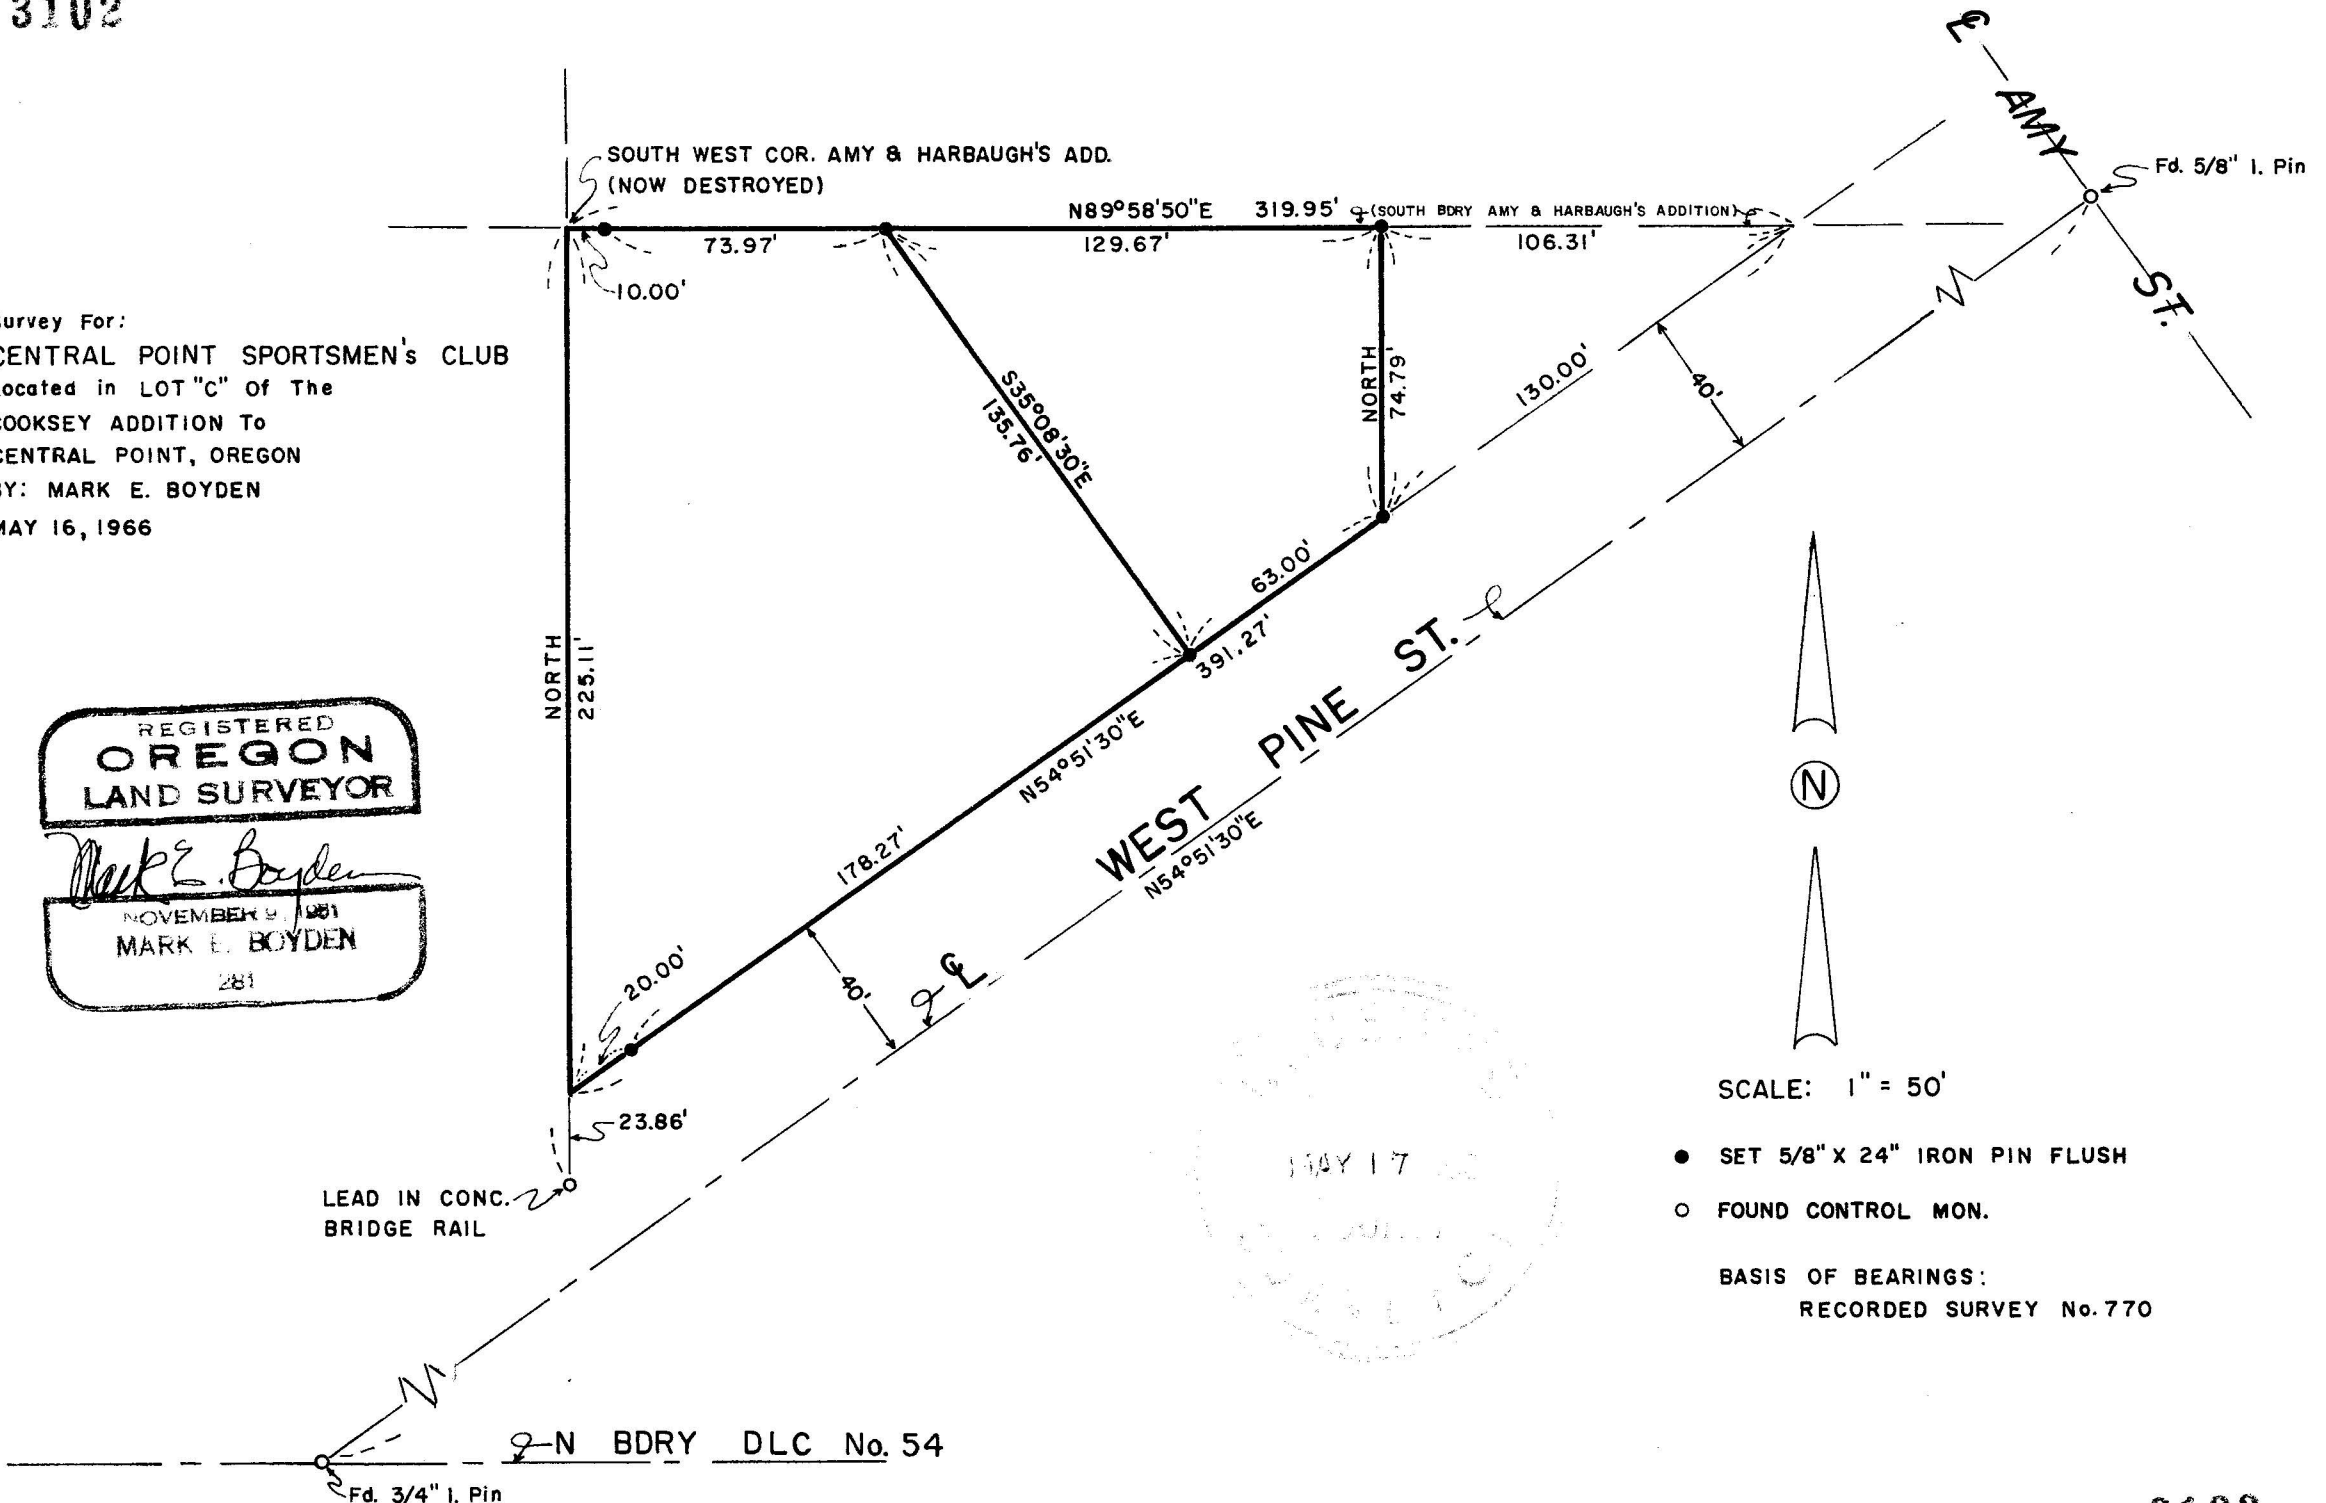

SURVEY NARRATIVE TO COMPLY WITH O.R.S. 209.250  
REVISED BY CHAPTER 555, O.L. 1963

FOR: Central Point Sportsmen's Club  
415 Hazel Street  
Central Point, Oregon

PURPOSE: From the tract previously monumented on Recorded Survey No. 770, excepting the parcel deeded to the City of Central Point (see Deed Volume 569, Page 96), monumented and described the remaining parcel in two tracts.

PROCEDURE:

Found monuments as shown for control of the centerline of West Pine Street. Also found the lead in the concrete bridge rail, as set by this office on Recorded Survey No. 770 for a line point on the West property boundary.

From said controls, monumented the tracts as shown on the attached map.

May 16, 1966

