

CHARLES H. HURST, L. S.
REGISTERED PROFESSIONAL LAND SURVEYOR
CONSULTING FORESTER
765 SUNRISE AVENUE
MEDFORD, OREGON 97501

. 3103

May 1, 1966

Jackson County Surveyor
Court House
Medford, Oregon

Dear Sir:

During the course of some reconnaissance work in Section 15, Township 37 South, Range 1 East of the Willamette Meridian, the east quarter corner thereof which has escaped detection in times past was recovered.

Original survey notes call for a 3" Black oak bearing N 9°W 56 links (36.96 feet) and a 20" laurel bearing N 35°E 111 links (73.26 feet).

The laurel has been fire scarred and the oak was found with scribing intact on the ground adjacent the root crown hole, said oak being 6" in diameter showing no external face but revealing reverse scribing after being split open.


On the basis of the above evidence, I rehabilitated this corner as follows:

Set a 3/4"x30" iron pin with brass cap from which I scribed a 8" White oak "4S14 483BT" which bears N 18 3/4°E 34 links and a 6" White oak "4S15 483BT" which bears S 48 1/2°W 30.5 links, 6" oak root crown hole bears N 12 1/4°W 56 links, 20" + madrone bears N 33 1/2°E 111 links.

Distances to original bearing trees were held superior to bearing.

Sincerely,

Charles H. Hurst

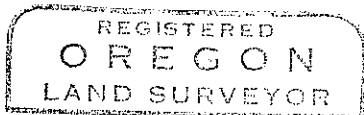

Charles H. Hurst

