

SURVEY FOR: JOHN D. MURPHY, 145 ALIDA ST.,  
ASHLAND, OREGON.

LOCATION: SE. 1/4 OF SE. 1/4, SECTION 19,  
T. 38S., R. 1W., W.M.

- = MONUMENTS FOUND AS DESCRIBED
- = 1/2" + 30" IRON RODS SET, FLUSH TO 2" EXPOSED.

DATE: JUNE, 1966

SCALE: 1" = 200'

BEARINGS BY SOLAR OBSERVATION.


REGISTERED  
OREGON  
LAND SURVEYOR

*L. E. Ager*

MARCH 10, 1944  
L. E. AGER  
21

+ ON TOP OF  
SECTION COR. 4" + 6" + ? GRANITE  
T. 38S., R. 1W. W.M. STONE

19	20
30	29

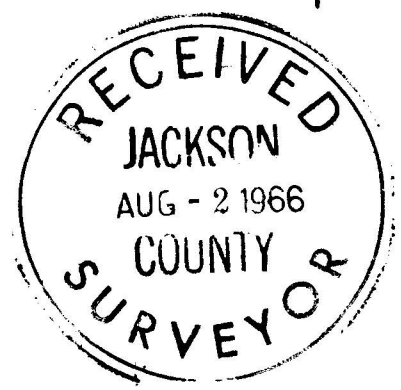

1/4 COR. (STUMPS OF ORIG. B.T.s)  
19 FOUND 1 1/2" IRON PIPE WITH DISC.  
STAMPED 404  
0.95'  
FOUND 1/2" IRON PIPE

SURVEY NARRATIVE TO COMPLY WITH O.R.S. 209.250

FOR: John D. Murphy, 145 Alida Street, Ashland, Oregon.

LOCATION: Southeast Quarter of the Southeast Quarter of Section 19, Township 38 South, Range 1 West, W.M.

PURPOSE: To monument the boundary corners of tract shown on map.

PROCEDURE: The granite stone with + on top shown for the corner of Sections 19, 20, 29 and 30 has been used as such over 20 years to my knowledge as it was in place in 1945 when I retraced the North and West lines of Section 29. From this corner I ran a random line to the Quarter corner between Sections 29 and 30, tying in an iron pipe at the approx. 1/16 th corner. I found this pipe to be on true line and midway between the Section corner and the Quarter corner. At the Quarter corner I found the stumps of the original bearing trees intact, scribe visible. Found a 1 1/2 inch in place for corner which I used for true corner.

Along the North-South 1/4 line I found iron pipes as shown on map, which I used for control.

Solar taken for bearing June 20, 1966 at 3:45 P.M. Pacific Standard Time.

Sun app. decl. = 23° 26' 35"

Mean Vert. angle = 41° 58' Lat. 42° 15'  
 Comp. sun bearing = S. 84° 36' W.  
 Angle R. sun to line 5° 11'  
 Line bearing S. 89° 47' W.

Solar taken on South line of Section 19.

