



To Old Stage Road

1/2" Steel Pins

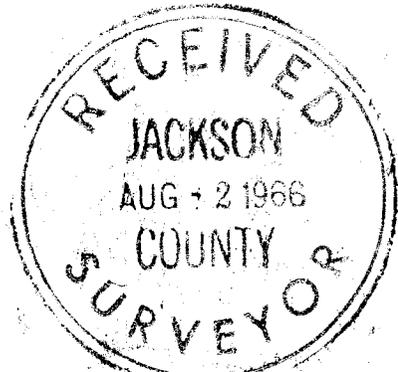

SURVEY PLAT
 for
Mrs. Ferned Kellow et al.
D.L.C. #45 T. 37 S. R. 2 W.
Jackson County, Oregon
Jan. 1965 Hugh C. Ingle
Scale 1" = 200' Civil Engineer

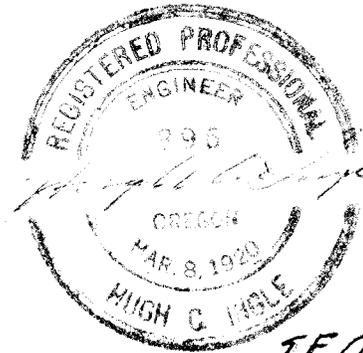

J.E. Cox
 D.L.C. #45
 Found 1 1/2" dia. Pipe

Survey Narrative to Comply with Section 87-330
1947 Oregon State Laws.

Survey for: Fernea Kellow and neighbors

Location of Survey:

Donation Land Claim #45 in Township 37
South, Range 2 West of the Willamette
Meridian, Jackson County, Oregon.

Purpose of Survey:

To establish property lines and corners
of several tracts of land shown.

Survey Procedure:

Bearings established from Solar observations.
Line sighted between Southeast corner of
Donation Land Claim #45 and railroad iron
at Northwest corner of Donation Land
Claim #54. Lines were run on North and
South boundaries conforming to previous
monuments and with boundary of property
on the South. Parcels divided as requested
and shown.

