


SURVEY MAP OF PROPERTY
 SITUATE IN
 SECTION 16, T. 35 S., R. 4 W., W.M.
 JACKSON COUNTY OREGON
 FOR
CARL E. PETERSON
 AND
RALPH WHITE-LOUISE SPECK & E. SPECK
 J. A. HOFFBUHR, REG. L.S. MEDFORD, OREGON
 SCALE 1" = 400' BEARINGS BY SOLAR OBSERVATION
 SET 5/8" X 24" IRON REINF. PINS
 AUGUST 12, 1966

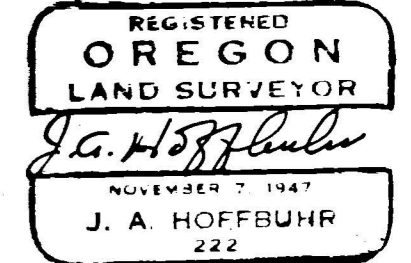

Survey Narrative To Comply With Paragraph 209.250
Oregon Revised Statutes

SURVEY FOR: Carl E. Peterson
Route 1 Box 44, Rogue River, Oregon
and
Ralph White
West Evans Creek Road, Rogue River, Oregon
and
Louise Speck
West Evans Creek Road, Rogue River, Oregon

LOCATION: Tracts situated within Section 16, Township 35
South, Range 4 West, Willamette Meridian,
Jackson County, Oregon.

PURPOSE: To monument and describe the boundaries of the
tracts indicated on the attached map. (The
White tract survey was necessary to correct
the description in Jackson County Deed Record
Volume 519 Page 187.)

PROCEDURE: The section perimeter was traversed and the
section was subdivided as required, the center lines of Menthorne
Road and West Evans Creek Road were established from the Jackson
County Road Record notes. The tracts were monumented and described
as indicated. Basis of bearings--Solar Observation.

August 12, 1966

J.A. Hoffbuhr
Registered Land Surveyor

