



Survey for:  
**MEDFORD MAIL TRIBUNE**  
 of Lots 1-3, Block 57  
 Original Town of  
 Medford, Oregon  
 By: Mark E. Boyden  
 August 11, 1966

3165


○ Set 5/8" X 24" iron pin flush

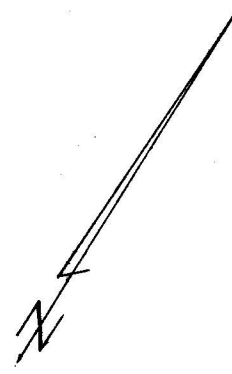

SCALE: 1"=60'

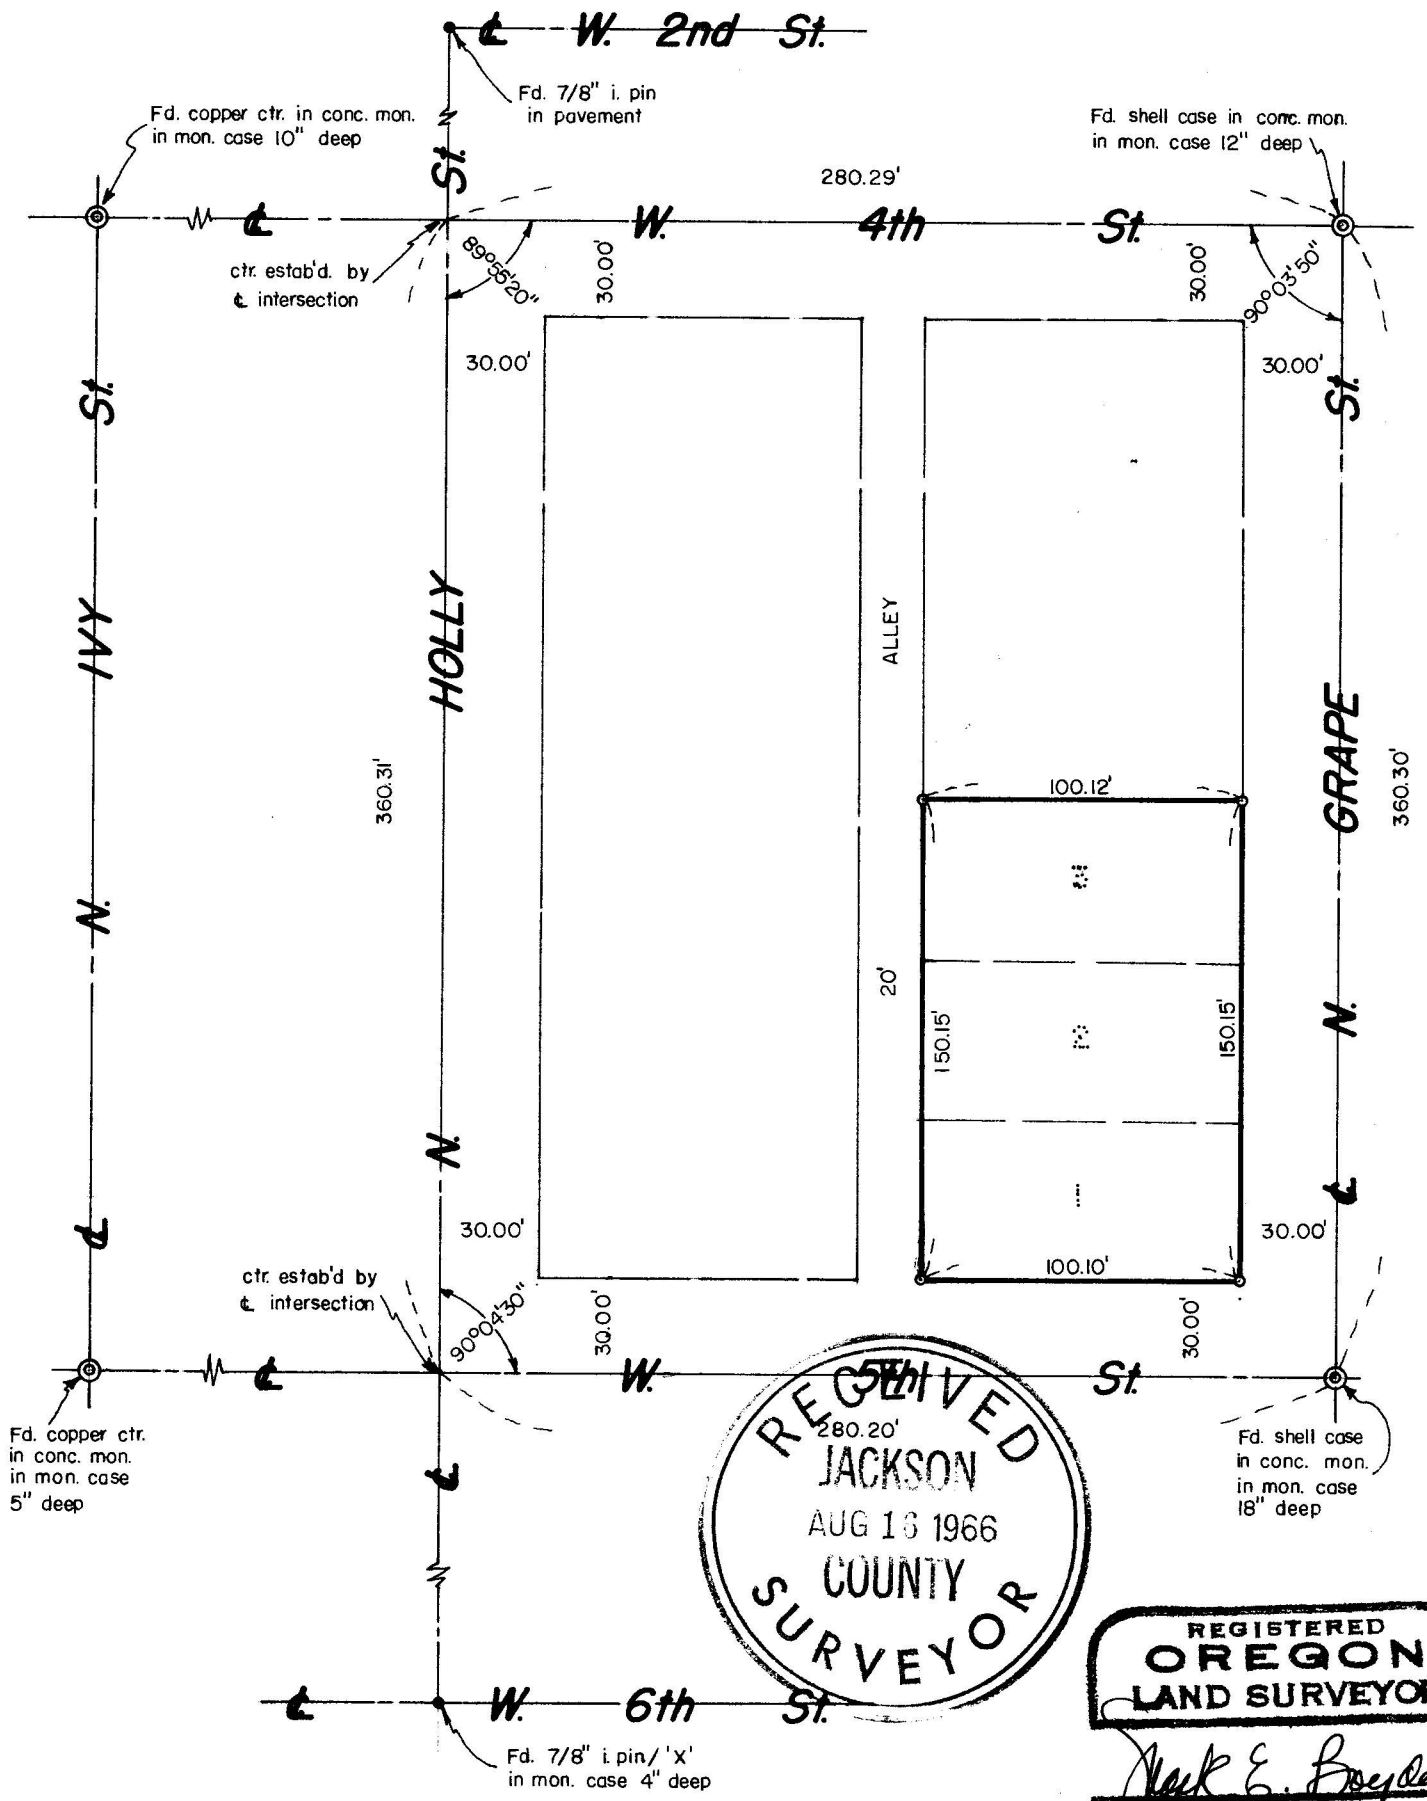

3165

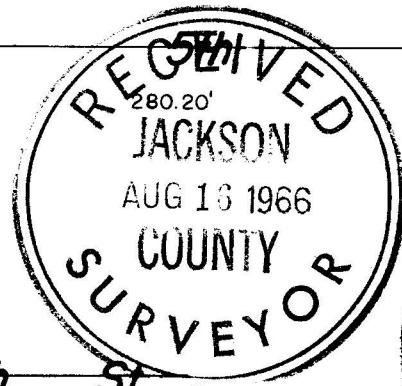

*Mark E. Boyden*  
 NOVEMBER 9, 1966  
 MARK E. BOYDEN  
 281

SURVEY NARRATIVE TO COMPLY WITH O.R.S. 209.250,  
REVISED BY CHAPTER 555, O.L. 1963

FOR: Medford Mail Tribune  
33 North Fir Street  
Medford, Oregon

PURPOSE: To monument the boundaries of Lots 1-3, Block 57, original town of Medford, Oregon.

PROCEDURE:

Found street centerline monuments established by the City of Medford.

Established the non-monumented street centers on Holly Street by straight line intersection from control monuments as shown.

Measured the angles and distances around said Block 57 on the street centerlines, and proportioned the lot corner positions as indicated.

August 10, 1966

