

3181



NE 1/4

UPTON RD.

WILSON RD

GEBHARD RD.

N 89° 54' W

30' 30"

SUR. NO. 2531

N 89° 54' W D.R. WEST

128.78'

545.73'

FD. E. 1/4 COR. SEC. 35

646.50'

S 0° 06' W, D.R. SOUTH, 676.50'

646.50'

N 0° 06' E, D.R. NORTH, 676.50'

128.78'

SURVEY IN NE. 1/4, SEC. 35, T36S, R2W.
FOR
MRS. RALPH MITCHELL


64-16

BY EDWARD MCGINTY
MEDFORD OREGON
JULY 1966

SCALE 1" = 150'
● = 5/8" IRON PIN

REGISTERED
OREGON
LAND SURVEYOR

JULY 10, 1853
EDWARD A. MCGINTY
301

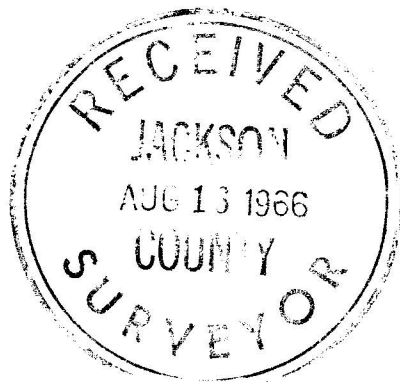


3181

Survey Narrative to comply with O.R.S. 209-250:

Survey for: Mrs. Ralph Mitchell
698 Wilson Rd.
Central Point, Oregon

Survey by: Edward A. McGinty, L.S.
July 1966

BASIS OF BEARING: Survey No. 1670

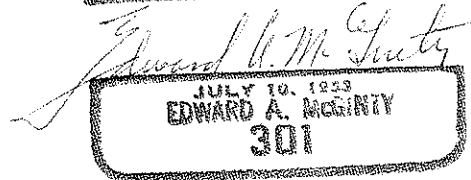

PRECEDENCE OF SURVEY:

From previous survey control along Wilson Road shown on Survey No. 2531, survey tract as shown.

Deed Record angles were held from Wilson Road.

East one quarter corner of Section 35, being a 5/8 inch iron pin approximately 6 inches deep, monuments set being 5/8 x 20 inch iron pins, set approximately flush with surface.

