


FOUND 1/4 SEC. COR.
3" BRASS DISC
N89° 35' 45" W 3118.50'

FOUND 1/4 SEC. COR.
1" GALV IRON PIPE
S89° 35' 45" E 1318.51'
(REC. S89° 32' E 1320')

N.W. COR. LOT 18
STEWART ACRES
SUBDIVISION

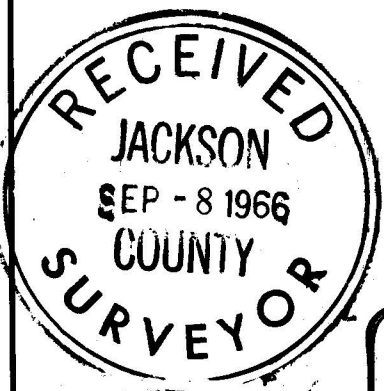

REGISTERED
OREGON
LAND SURVEYOR
J. A. Hoffbuhr
NOVEMBER 7, 1947
J. A. HOFFBUHR
222

MAP OF SURVEY
LOCATED IN
N.E. 1/4 SEC. 16, T. 37 S., R. 1 W., W. M.
JACKSON COUNTY OREGON
FOR
CARL QUACKENBUSH

J. A. HOFFBUHR, REG. L.S., MEDFORD, OREGON
SCALE, 1"=100' APRIL 22 1966
BASIS OF BEARING- R/S NO. 2829
o = SET 5/8" X 24" STEEL REINF. PIN
• = FOUND 5/8" IRON PIN

Survey Narrative To Comply With Paragraph 209.250
Oregon Revised Statutes

SURVEY FOR:

Carl Quackenbush
Egan Orchard
Foothills Road
Medford, Oregon

LOCATION:

Tract situated in the Northeast One Quarter
(1/4) of Section 16, Township 37 South,
Range 1 West, Willamette Meridian, Jackson
County, Oregon.


PURPOSE:

To monument the corners of the tract as in-
dicated on the attached map.

PROCEDURE:

The controls for Recorded Survey No. 2829 were
used to establish the South and East lines of the tract, the West
line was controlled by the alignment of Foothills Road and the
Northeasterly line by the client, being a portion of an overall
tract. Basis of bearings--Recorded Survey No. 2829.

August 16, 1966

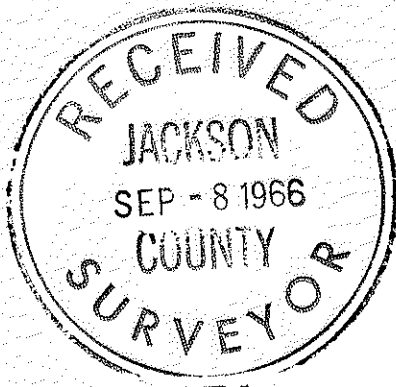

J.A. Hoffbuhr
Registered Land Surveyor

