


Survey For  
 ERNEST HUMBLE  
 Located in D.L.C. 50 in  
 The N.W. 1/4 Sec. 1, T. 38S., R. 2W.  
 By: Mark E. Boyden  
 Sept. 27, 1966

REGISTERED  
**OREGON**  
 LAND SURVEYOR  
*Mark E. Boyden*  
 NOVEMBER 9, 1961  
 MARK E. BOYDEN  
 281

3230

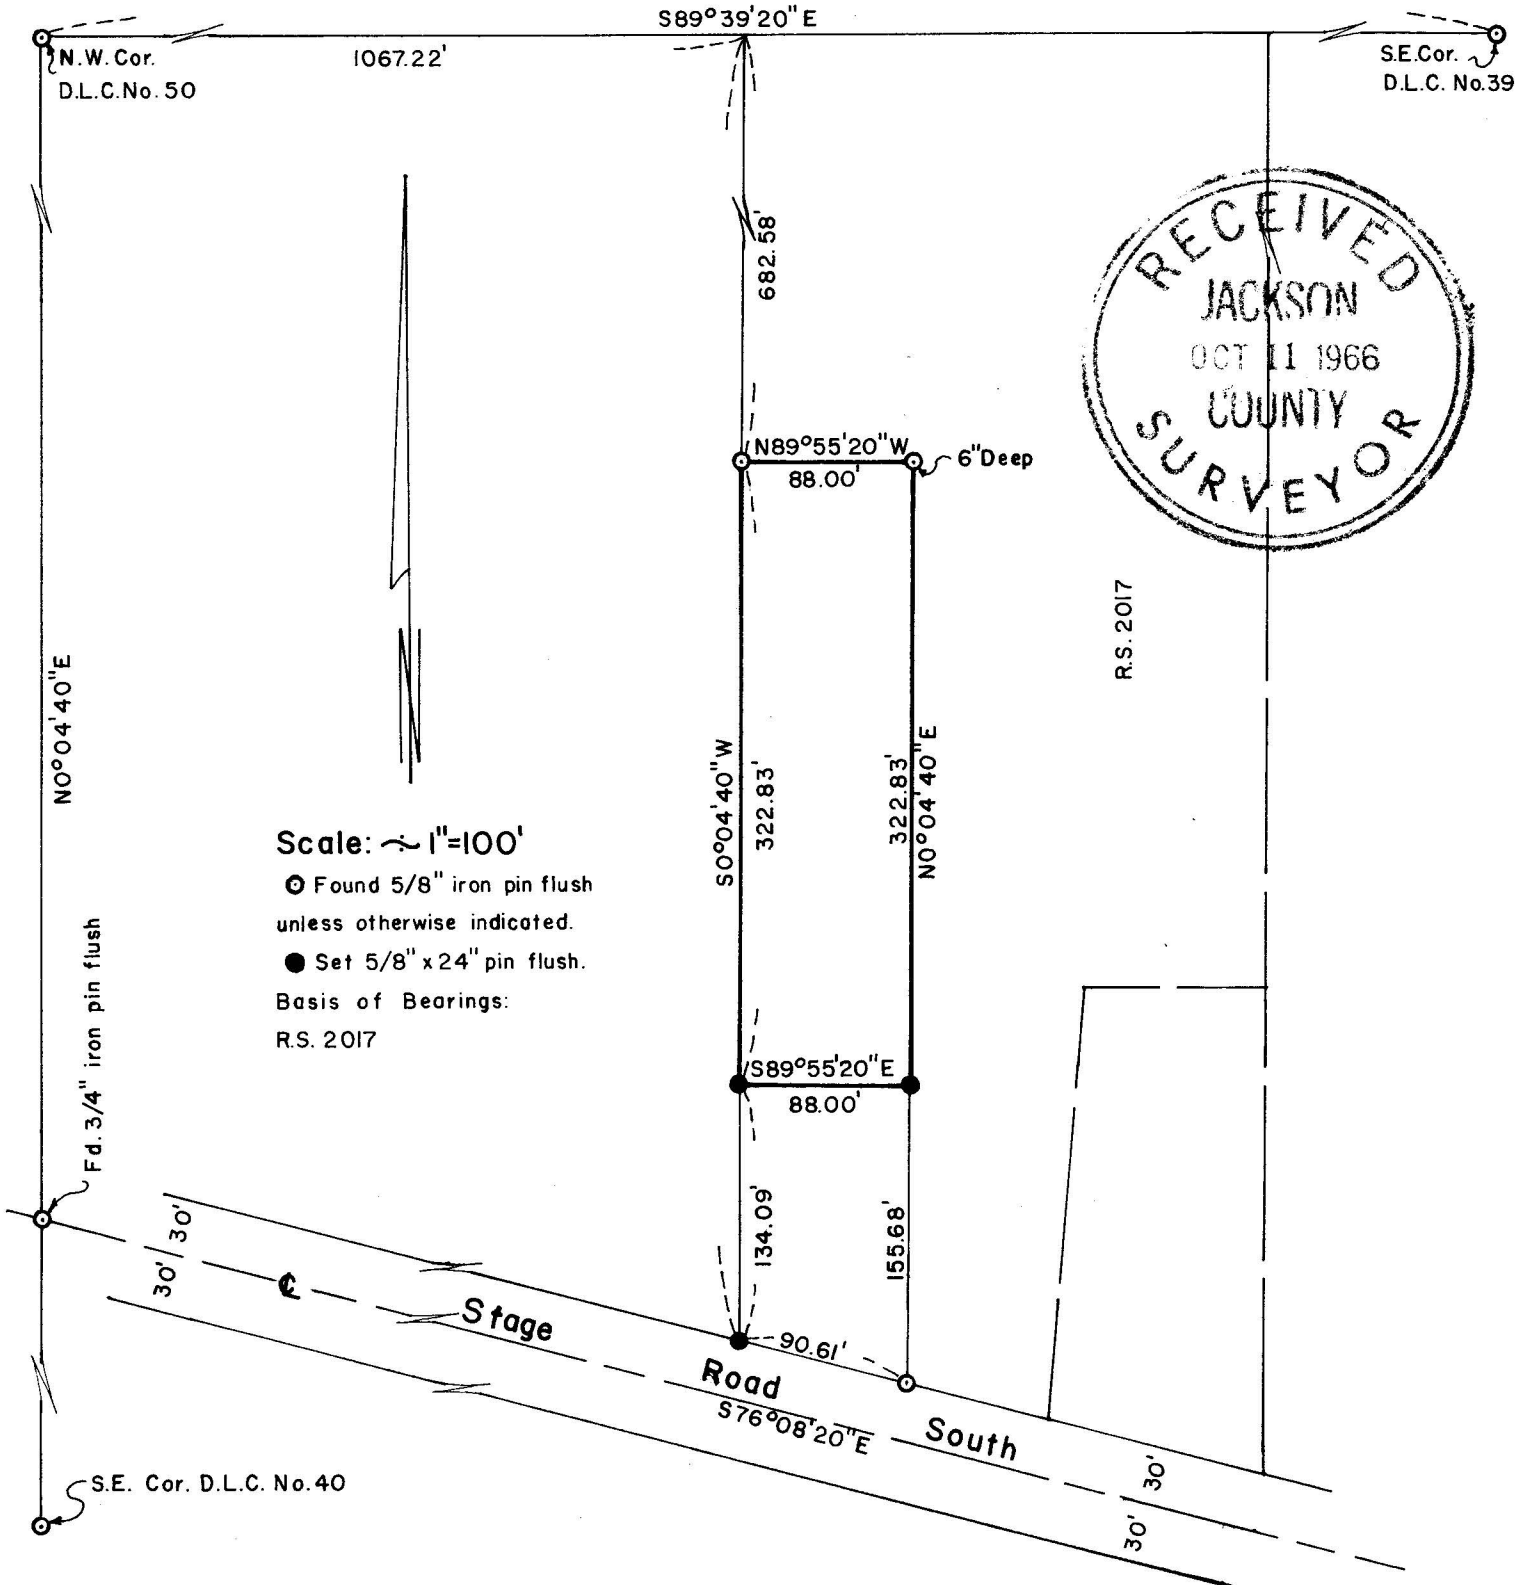

3230

SURVEY NARRATIVE TO COMPLY WITH O.R.S. 209.250  
REVISED BY CHAPTER 555, O.L. 1963

FOR: Ernest Humble  
406 Fourth Street, N.W.  
Apt. B  
Puyallup, Washington

PURPOSE: To monument the tract now described in Deed Records,  
Volume 569, Page 52.

PROCEDURE:

Since the tract to be monumented is a portion of a tract  
excepted from the Westerly side of the property surveyed by this  
office and filed as recorded Survey No. 2017, all controls had  
been established. Recovered the monuments as shown and set  
additional iron pins as indicated on the map to accompany this  
report.

September 27, 1966

