

SURVEY IN NE. 1/4 SEC 2 T.35S.,R2W.WM
 FOR
 BUD PERKETT
 66 - 39


BY EDWARD A. MC GINTY
 MEDFORD OREGON
 AUGUST 1966

SCALE 1" = 200'
 ○ = 5/8" IRON PIN
 ⊙ = FD. 1" IRON PIPE

REGISTERED
 OREGON
 LAND SURVEYOR

Edward A. McGinty

JULY 10, 1933
 EDWARD A. MCGINTY
 301

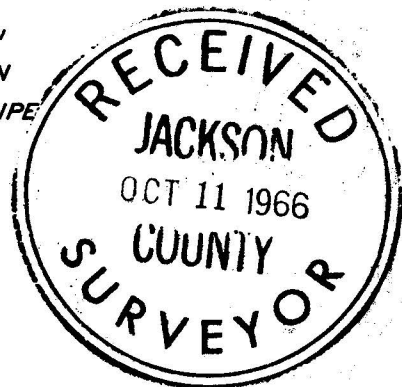


Survey No. 3238

Survey Narrative to comply with O. R. S. 209-250.

Survey for: Mr. Bud Perkett
Rt. 2, Box 576-E
Central Point, Oregon

Survey by: Edward A. McGinty, L.S.
August, 1966

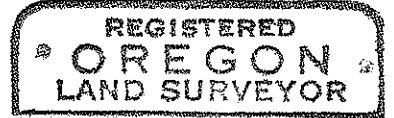

Edward A. McGinty



BASIS OF BEARING: Jones County Road data.

PRECEDENCE OF SURVEY:

Surveyed tract of land as shown. Dashed line indicating approx. boundaries only, and are not to be construed or intended to be otherwise. The client is aware of this fact.

MONUMENTS:

N. 1/4 cor. found a 1 in. iron pipe, 4 ins. high.

Monuments set being 5/8 x 20 in. iron pins, set approx. flush with the surface.

