

SURVEY IN E-1/2 SEC-1 T36S.R2W & SEC 6 T36S R1W  
 FOR RAY RYAN  
 66-24

BY EDWARD A. MC GINTY  
 MEDFORD OREGON  
 JUNE 1966

SCALE 1"=200 FT  
 • = 5/8" I. PIN

REGISTERED  
 OREGON  
 LAND SURVEYOR  
 Edward A. McGinty  
 EL. 301

RECEIVED  
 JACKSON  
 OCT 11 1966  
 COUNTY  
 SURVEYOR

Survey Narrative to comply with O.R.S. 209-250:

Survey for: Ray Ryan  
Modoc Rd.  
White, City, Oregon

Survey by: Edward A. McGinty  
Registered Land Surveyor  
June, 1966

BASIS OF BEARING: Solar Observation



PRECEDENCE OF SURVEY:

Monuments set being 5/8 x 24 in. iron pins, set approx. flush with the surface.

Monuments Found:

- A. Conc. mon. @ 1/4 cor., 6 ins. high.
- B. Conc. mon., approx. 1.5 ft. deep.
- C. Conc. mon., bears N.89°37'10"E., 10.00 feet from the S 1/4 cor. of Sec. 1.
- D. 3/4 in. iron pin.
- E. 3/4 in. iron pipe near the County road PT.

Remarks: Only a partial survey was made in sub-dividing the SE. 1/4 of Sec. 1, at the request of client. The lines shown near the southerly and westerly line of the NE. 1/4 of the SE. 1/4 of the Sec. are approx. only, and client is aware of this.

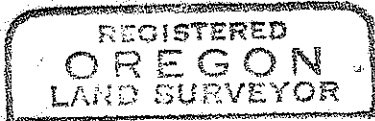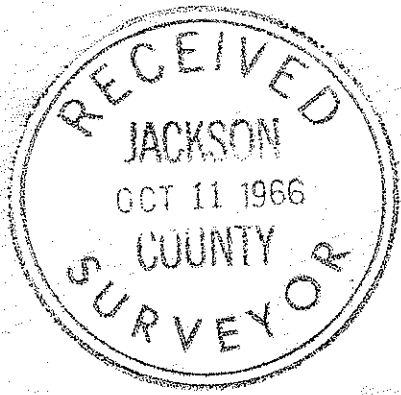

*Edward A. McGinty*

