

3088

3262

Find 3/4" Iron Pipe  
SET IN COLL.

COUNTY SURVEY # 1221

SOUTH 65.00' SOUTH 181.50'

N 89° 55' 15" E 156.42'

PARCEL 2

N 89° 55' 15" E 156.42'

PARCEL 1

S 89° 55' 15" W 116.36'

60' R/W

E. MAIN STREET

Fd 5/8" IR, COUNTY  
SURVEY No 1871

Fd. MONÉ JACKSON ST.

NORTH 65.00' NORTH 141.44'

60' R/W

CRATER LAKE AVE.

BASIS OF BEARING


INITIAL POINT OF SURVEY



40.06' 40.06' 30.00'


S 89° 55' 15" W 116.36'

Fd 5/8" S.E. COR. D.L.C. 42

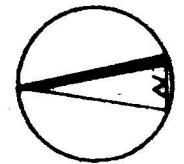

SCALE: 1" = 40'  
O Fd 1" IP 1/4"  
● SET IP 3/4"

IP = IRON PIPE  
IR = IRON ROD

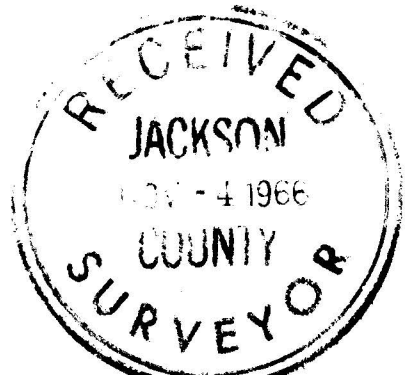

PROPERTY SURVEY  
FOR  
SHELL OIL COMPANY  
N.E. 1/4 SEC. 30, T37S, R1W, WM  
MEDFORD, JACKSON COUNTY, OREGON

WESTERN ENGINEERING CONSULTANTS  
1015 W. CLEVELAND STREET EUGENE, OREGON

JOB NO. 4064	DRAWN L.B.	DATE 9-8-1966	CHECKED L.N. H
-----------------	---------------	------------------	-------------------

3262

Narrative Description  
to  
Comply ORS 209.250

Survey for: Boundary Survey for Shell Oil Co., 1240 Hillendale Drive, Salem, Oregon.

Purpose of Survey: To monument and describe lease property at Northeast corner of Crater Lake Avenue and East Main Street in Medford, Oregon.

Survey Procedure: Found Street intersection monuments and other survey monuments, as indicated on map, for basis of survey control. Set 3/4" steel pipes.

