


BASIS OF BEARING: COUNTY RECORDS
 • POUND CORNERS: L.P. LOVEJOY SURVEY #1070
 3/4" IRON PIPES SET IN CONCRETE

(Fd) NC 1/16 Found pins to NE & S referencing Cor. and Hub in pavement at the NC 1/16

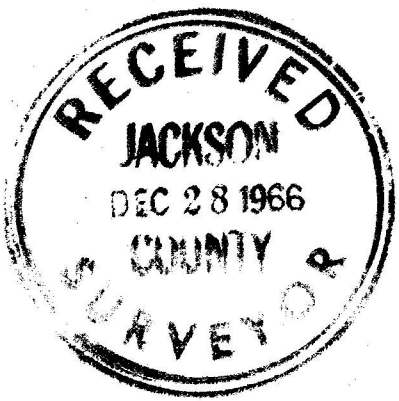

REGISTERED OREGON LAND SURVEYOR
Ray W. Bergmann
 MAY 7, 1954
 RAY W. BERGMANN
 316

PROPERTY SURVEY
 FOR PACIFIC POWER & LIGHT COMPANY
 IN NE 1/4 OF SEC. 20, T. 37 S., R. 1 W., W.M.

DRAWN BY RAY BERGMANN NOV. 10, 1966.
 SCALE: 1" = 40'

3304

3304

SURVEY NARRATIVE TO COMPLY WITH O.R.S. 209.250



FOR: Pacific Power & Light Co.
216 W. Main St.,
Medford, Oregon

PURPOSE: To locate and monument a parcel, lying in the
NE 1/4 Sec. 20 T.37S, R.1 W, W.M.

BASIS OF BEARING: Record bearing along the line between 1/4
17/20 and NC 1/16 Sec. 20

PROCEDURE: The quarter corner between Sections 17/20, NC 1/16
Sec. 20 and the NE Cor of Sec. 20, T.37S., R.1 W, W.M. were found in
the field. The 1/4 Cor was occupied a sight taken on the NC 1/16
and the angle to the NE Cor Section 20 turned. It was noted the
bearing checks within 1 minute of survey #1070 and flat with Stewart
Acres plat. A chained loop was run around the property to be surveyed
with a 300' chain which had been standardized with the new County Base
line. The corners set by Mr. Lovejoy, survey #1070 near the NE & SE
corners of the property were found as were the corners at the S. side
center and SW corners. The corners checked within 0.15' of the record
distance. Our loop closed with a precision of 1'/17,000' for distance,
1 minute in angles.

Obstacles on the west side of the property prevented
us from checking the angles of the new NW & SW corners. The angles at
NE & SE corners checked.

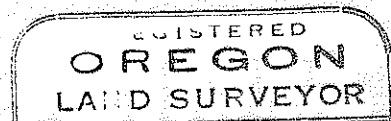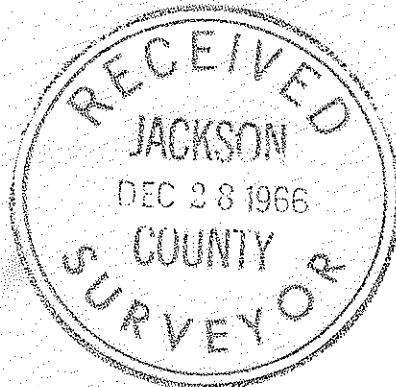

Ray W. Bergmann

