

Survey: Hillendale Park Subdivision (Survey No. 3322)

Surveyor: Charles H. Hurst
304 South Holly
Medford, Oregon 97501



Purpose : To enter into the record witness trees taken pertaining to the perpetuation of the SW corner of DLC 41, T. 35 S, R. 1 W., W.M. (Section 14)

Scribed a 8" White oak N $76\frac{1}{2}^{\circ}$ E 75.98 feet distant
Scribed a 10" White oak S $40\frac{1}{2}^{\circ}$ E 41.33 feet distant

No witness trees were taken for the SE corner of DLC 41.

Note: Drafting error south line Lot 4, Block 3: Dimension of 218.94' should be 167.00'.

May 17, 1979

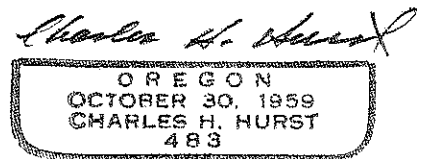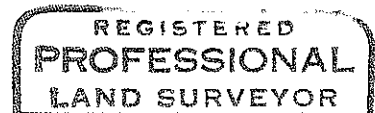

T35S, R1W, SEC 14